


Map No. **KANSAS** Sec. 20 Twp. 27 R. 2^E

Well No. 2 - Vickers Farm

Magnolia Pet Company

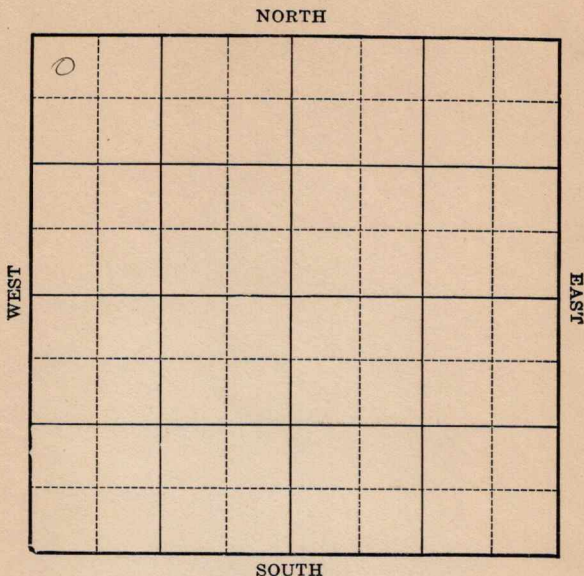

Location _____
Drilling Remarks _____

Rig Up _____
Drilling Remarks _____

RECORD

Cased _____ in. _____ ft.
Sand _____
Gas _____
Oil _____
Total Depth _____

PRODUCTION

1st 24 hrs. Nat. _____
1st 24 hrs. after shot _____
Gas _____ cu. ft. _____
Dry Hole _____
Abandoned _____


Map No. **KANSAS** Sec. 20 Twp. 27 R. 2^EWell No. 2 Vickers FarmMagnolia Company

NORTH

330 Ft. from N. Line

Ft. from S. Line

Ft. from E. Line

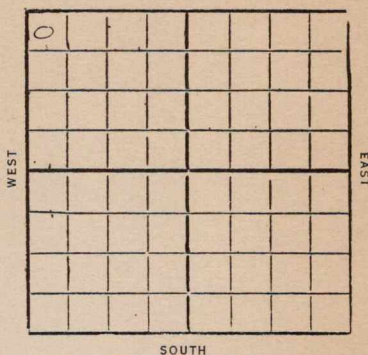330 Ft. from W. Line1930

Date

REPORT

12/17 Log
12/23 Key
12/30 & Stud
1/31
1/17 Drly 1235
1/14 " 1625
1/21 VIR 10"-1770
1/28 drly 2300'
2/4 " 2880'
2/11 Top Chat 2909
T.D. 2917
Swab 70 bbl 10 hr
2/18 Chat 2909-38
T.D. 2938
Swab 100 bbl oil
Comp

Map No. 12 **KANSAS** Sec. 20 Twp. 27 R. 2E

Well No. 2 Vickrell

Magnolia P & S Company

Contractor

SECTION PLAT

0			

330 Ft. from N. Line

..... Ft. from S. Line

..... Ft. from E. Line

830 Ft. from W. Line

FIRST REPORTS

Location ✓

Rig up

Drilling and Remarks:

RECORD

Cased.....in.,ft.

Sand

Gas

Oil

Total Depth.....

PRODUCTION

1st 24 hrs. Nat.....

1st 24 hrs. after shot.....

Gas.....Cu. Ft.

Dry Hole.....

Abandoned.....

Date

DEC 17 1930 192.....

S. J. LEWIS Scout

Map No. KANSAS Sec. 20 Twp. 27 R. 2EWell No. 2 VickersMagnolia P. & S. Company

Contractor

SECTION PLAT

380 Ft. from N. Line

Ft. from S. Line

Ft. from E. Line

380 Ft. from W. Line

0			

COMPLETED

Location

Rig up

Drilling and Remarks:

100 ft 100 ft

RECORD

Cased in., ft.

Sand 2909 - 88

Gas

Oil

Total Depth 2985

PRODUCTION

1st 24 hrs. Nat.

1st 24 hrs. after shot

Gas Cu. Ft.

Dry Hole

Abandoned

Date

FEB 18 1931

192

S. J. LEWIS Scout