


Map No. Kans Sec. 4 Twp. 23 R. 13
Well No. 1 Inthurn Farm
Skelly Oil Company

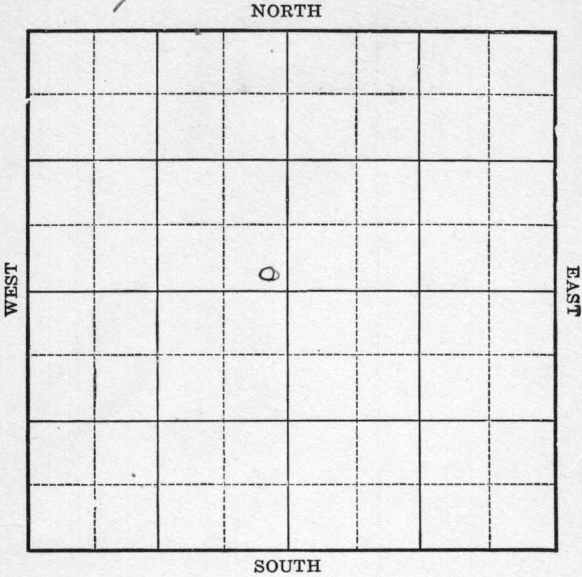

Location _____
Drilling Remarks _____

Rig Up _____
Drilling Remarks _____

RECORD

Cased _____ in. _____ ft.
Sand _____
Gas _____
Oil _____
Total Depth _____

PRODUCTION

1st 24 hrs. Nat. _____
1st. 24 hrs. after shot _____
Gas _____ cu. ft.
Dry Hole _____
Abandoned _____

Map No. 16000 Sec. 4 Twp. 23 R. 13^EWell No. 1 InthurnArcler oil Co Company

Contractor

COMPLETED

SECTION PLAT

Ft. from N. Line

200 Ft. from S. Line200 Ft. from E. Line

Ft. from W. Line

Location

Rig up

Drilling and Remarks:

Plugged Back to1656'shot 40 gts35 bls

RECORD

Cased _____ in., _____ ft.

Sand 1645-50'

Gas _____

Oil _____

Total Depth 1730'

PRODUCTION

1st 24 hrs. Nat. _____

1st 24 hrs. after shot _____

Gas _____ Cu. Ft.

Dry Hole _____

Abandoned _____

Date

APR 10 1925

192

Chas. L. Sherwood Scout

Map No. **KANSAS** Sec. 4 Twp. 23 R. 13

Well No. 1 Dan Thurn

Shelly Oil Company

Contractor

FIRST REPORT


SECTION PLAT

_____ Ft. from N. Line

200 Ft. from S. Line

200 Ft. from E. Line

_____ Ft. from W. Line

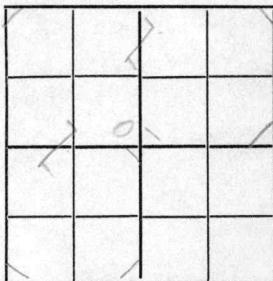

Location _____

Rig up _____

Drilling and Remarks:

Mac.

RECORD

Cased _____ in., _____ ft.

Sand _____

Gas _____

Oil _____

Total Depth _____

PRODUCTION

1st 24 hrs. Nat. _____

1st 24 hrs. after shot _____

Gas _____ Cu. Ft.

Dry Hole _____

Abandoned _____

Date

DEC 11 1924

192

M. A. BENEAR

Scout