

Map No. _____ Sec. 16 Twp. 23 R. 13E
 Well No. 25 Shaffer & Howell Farm _____
 _____ (Sauder) Company

NORTH

WEST

EAST

SOUTH

Location _____
 Drilling Remarks _____

Rig Up _____
 Drilling Remarks _____

RECORD

Cased _____ in. _____ ft.
 Sand _____
 Gas _____
 Oil _____
 Total Depth _____

PRODUCTION

1st 24 hrs. Nat. _____
 1st 24 hrs. after shot _____
 Gas _____ cu. ft. _____
 Dry Hole _____
 Abandoned _____

KANSAS

Map No. _____ Sec. 16 Twp. 23 R. 13E

Well No. 2- Soder Farm _____


Shaffer & Howell Company _____

380 Ft. from N. Line

_____ Ft. from S. Line

250 Ft. from E. Line

_____ Ft. from W. Line

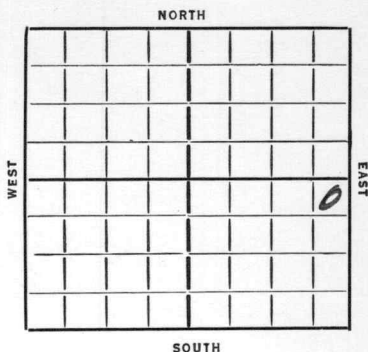

SPECIAL

REPORT

Date 1935
9/25 Machine
10/3 delg 150
10/10 " 615
10/30 TML 1730
 Oil 1745-57
 TD 1759
 1000 acub
 135 bbls.

COMPLETED

Map No. 17 Sec. 16 Twp. 23 R. 13EWell No. 2-SonderShaffer + Hornell Company

Contractor

COMPLETED

SECTION PLAT

			o

380 Ft. from N. Line

Ft. from S. Line

250 Ft. from E. Line

Ft. from W. Line

offset

Location

Rig up

Drilling and Remarks:

1000 acid135 lbs

RECORD

Cased _____ in., _____ ft.

Sand TML 1730

Gas _____

Oil 1745-57Total Depth 1759

PRODUCTION

1st 24 hrs. Nat. _____

1st 24 hrs. after shot _____

Gas _____ Cu. Ft.

Dry Hole _____

Abandoned _____

Date

10-30-35 192

ORVAL MANNSCHE Scout

KANSAS

Map No. 17 Sec. 16 Twp. 23 R. 13EWell No. 2-SoderShaffer & Howell Company

Contractor

FIRST REPORTS

SECTION PLAT

380 Ft. from N. Line

Ft. from S. Line

250 Ft. from E. Line

Ft. from W. Line

Location

Rig up

Drilling and Remarks:

RECORD

Cased.....in.,ft.

Sand.....

Gas.....

Oil.....

Total Depth.....

PRODUCTION

1st 24 hrs. Nat.....

1st 24 hrs. after shot.....

Gas.....Cu. Ft.

Dry Hole.....

Abandoned.....

Date

9-25-35 192.....Scout

ORVAL MANNSCHRECK