


Map No. 11 Sec. 17 Twp. 23 R. 13  
 Well No. 1 Bays Farm  
Plymouth Company

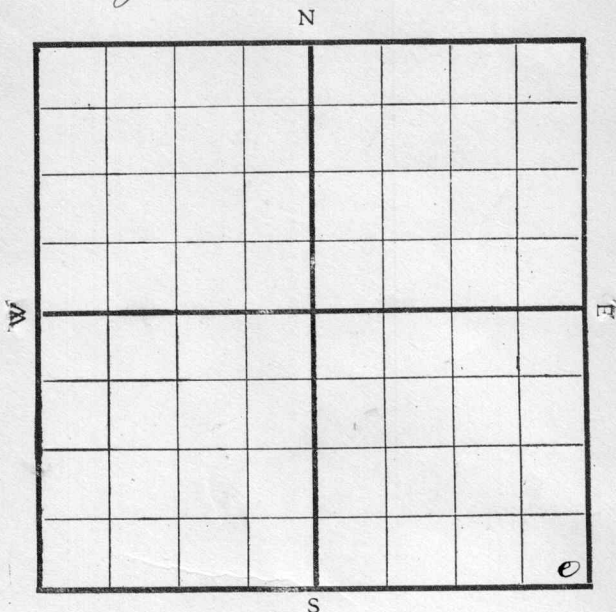

COMPLETED

Location -----  
 Drilling Remarks:

-----  
 -----  
 -----  
 -----  
 -----  
 -----  
 -----  
 -----  
 -----  
 -----  
 -----

RECORD

Cased ----- in. ----- ft.  
 Sand -----  
 Gas -----  
 Oil -----  
 Total Depth -----

Rig Up -----  
 Drilling Remarks:

-----  
 -----  
 -----  
 -----  
 -----  
 -----  
 -----  
 -----  
 -----  
 -----

PRODUCTION

1st 24 hrs. Nat. -----  
 1st 24 hrs. after shot -----  
 Gas ----- cu. ft.  
 Dry Hole -----  
 Abandoned -----

Map No. \_\_\_\_\_ Sec. 17 Twp. 23 R. 13


Well No. 1 Bays \_\_\_\_\_ Farm  
Plymouth \_\_\_\_\_ Company

\_\_\_\_\_ Ft. from N. Line

200 Ft. from S. Line

200 Ft. from E. Line

\_\_\_\_\_ Ft. from W. Line

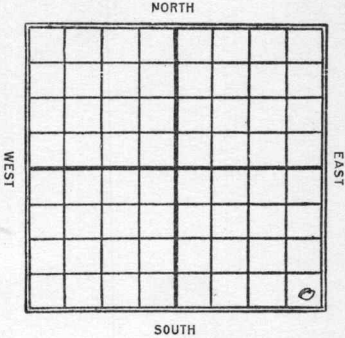

Date 1922

REPORT

|             |                              |
|-------------|------------------------------|
| <u>1/15</u> | <u>Reg bldg</u>              |
| <u>2/4</u>  | <u>Reg</u>                   |
| <u>3/30</u> | <u>Dlg at 1200'</u>          |
| <u>4/19</u> | <u>Sd 1745-63 40 gts</u>     |
|             | <u>Pumping 4 bbls of oil</u> |
|             | <u>9 4 bbls water</u>        |

Map No. K17 Sec. 17 Twp. 23 R. 13Well No. 1 DaysPlymouth Company.200' from S NORTH 200' from E,

|  |  |  |  |  |  |  |  |
|--|--|--|--|--|--|--|--|
|  |  |  |  |  |  |  |  |
|  |  |  |  |  |  |  |  |
First Report

WEST EAST

SOUTH

Location \_\_\_\_\_

Rig up \_\_\_\_\_

Drilling and Remarks:

Rig + Bldg.

## RECORD

Cased \_\_\_\_\_ in., \_\_\_\_\_ ft.

Sand \_\_\_\_\_

Gas \_\_\_\_\_

Oil \_\_\_\_\_

Total Depth \_\_\_\_\_

## PRODUCTION

1st 24 hrs. Nat. \_\_\_\_\_

1st 24 hrs. after shot \_\_\_\_\_

Gas \_\_\_\_\_ Cu. Ft.

Dry Hole \_\_\_\_\_

Abandoned \_\_\_\_\_

State KansasDate 1/13 1922 WMB

Scout

Map No. 17 Sec. 17 Twp. 23 R. 13Well No. 1 DaysDymouth Company

Contractor

COMPLETED

-----Ft. from N. Line

200 Ft. from S. Line200 Ft. from E. Line

-----Ft. from W. Line

## SECTION PLAT

|  |  |  |  |
|--|--|--|--|
|  |  |  |  |
|  |  |  |  |
|  |  |  |  |
|  |  |  |  |

Location -----

Rig up -----

Drilling and Remarks:

Sand 1745-63  
shot 40 g to  
pumping 4  
ftls. oil  
and 4 ftls water

## RECORD

Cased ----- in., ----- ft.

Sand -----

Gas -----

Oil -----

Total Depth -----

## PRODUCTION

1st 24 hrs. Nat. -----

1st 24 hrs. after shot -----

Gas ----- Cu. Ft.

Dry Hole -----

Abandoned -----

Date

APR 19 1922

M. A. BENEAR

-----191-----

-----Scout-----