
Greenwood

Form 51—5M—3-35—Mid-West

Map No. KANSAS Sec. 16 Twp. 23 R. 13-E

Well No. 5-Sauders Farm

Howell & Shaffer Company

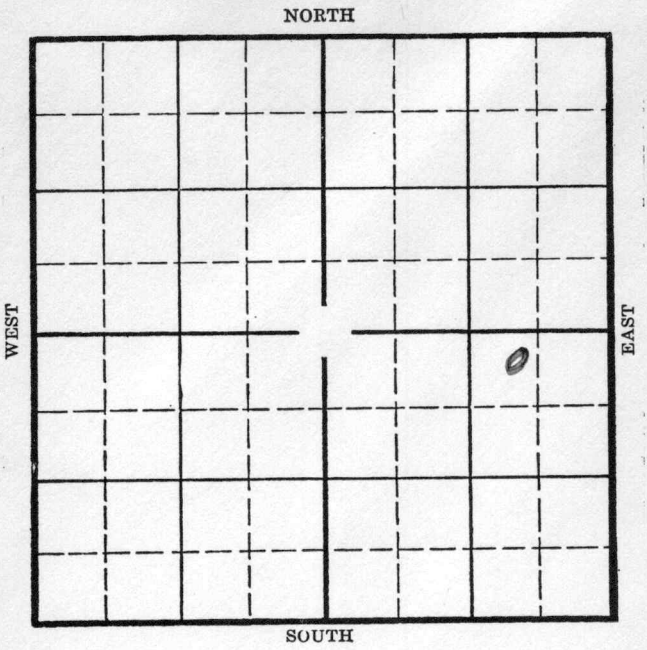

Location

Drilling Remarks

Rig Up

Drilling Remarks

RECORD

Cased in. ft.

Sand

Gas

Oil

Total Depth

PRODUCTION

1st 24 hrs. Nat.

1st 24 hrs. after shot

Gas cu. ft.

Dry Hole

Abandoned

Form 252-A
5M 7-35 MPC

Greenwood

Map No. KANSAS Sec. 16 Twp. 23 R. 13E

Well No. #5 Saunders Farm


Howell & Shaffer Company

365' Ft. from N. Line

_____ Ft. from S. Line

850' Ft. from E. Line

_____ Ft. from W. Line

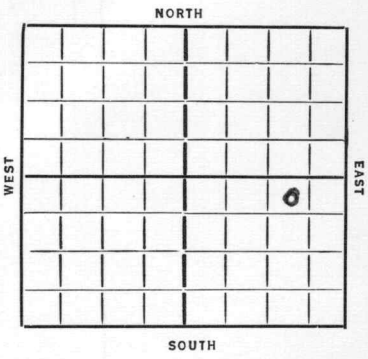

Date 1936	REPORT
5/13	Mach. Drlg. 850'.
5/21	Drlg. 1577'.
5/28	--
6/4	Pay 1725-39'. 235' oil.
6/10/36	-Lime 1725'.
	Total depth 1739'.
	1000 gallons acid.
	30 bbls oil.
	COMPLETED

Form 26—1M Bks.—2-29-C

Greenwood KANSAS


Map No. 17 M. Sec. 16 Twp. 23 R. 13 E

Well No. 5 Saunders

Howell & Shaffer Company

Contractor

SECTION PLAT

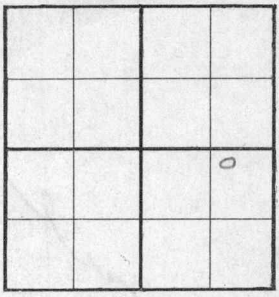

365 Ft. from N. Line

____ Ft. from S. Line

850 Ft. from E. Line

____ Ft. from W. Line

FIRST REPORT

Location ____

Rig up ____

Drilling and Remarks:

Mack
Drlg 850

RECORD

Cased ____ in., ____ ft.

Sand ____

Gas ____

Oil ____

Total Depth ____

PRODUCTION

1st 24 hrs. Nat. ____

1st 24 hrs. after shot ____

Gas ____ Cu. Ft.

Dry Hole ____

Abandoned ____

Date

MAY 13 1936 19 ____

S. J. LEWIS Scout

Form 26—1M Bks.—2-29

Greenwood


Map No. KANSAS Sec. 16 Twp. 23 R. 13E

Well No. 5 Sanders

Howell & Shaffer Company

Contractor

SECTION PLAT

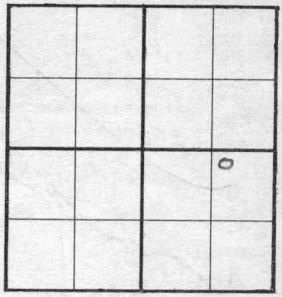

365 Ft. from N. Line

____ Ft. from S. Line

350 Ft. from E. Line

____ Ft. from W. Line

COMPLETED

Location ____

Rig up ____

Drilling and Remarks:

Lime 1725

1000 acid

30 Water.

RECORD

Cased ____ in., ____ ft.

Sand ____

Gas ____

Oil ____

Total Depth 1739

PRODUCTION

1st 24 hrs. Nat. ____

1st 24 hrs. after shot ____

Gas ____ Cu. Ft.

Dry Hole ____

Abandoned ____

Date

JUN 10 1936 19____

S. J. LEWIS Scout