


Map No. _____ Sec. 9 Twp. 23 R. 13

Well No. 2 Schiedler Farm

Theta Company

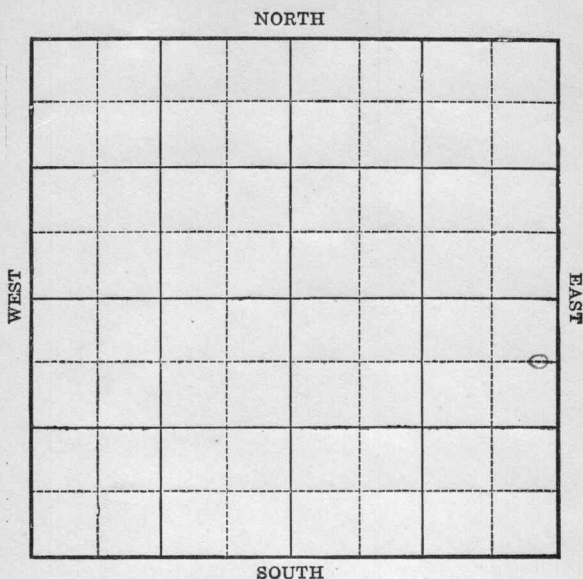

Location _____

Drilling Remarks:

Rig up _____

Drilling Remarks:

RECORD

Cased _____ in. _____ ft.

Sand _____

Gas _____

Oil _____

Total Depth_____

PRODUCTION

1st 24 hrs Nat. _____

1st 24 hrs. after shot_____

Gas _____ cu. ft.

Dry Hole _____

Abandoned _____

Map No. **KANSAS** *179* Sec. *23* Twp. *13* R. *13*

Well No. *2 Schindler*
Schindler Company

Contractor

FIRST REPORT

SECTION PLAT

760 Ft. from N. Line

Ft. from S. Line

200 Ft. from E. Line

Ft. from W. Line

Location

Rig up

Drilling and Remarks:

R.O.G.

RECORD

Cased in., ft.

Sand

Gas

Oil

Total Depth

PRODUCTION

1st 24 hrs. Nat.

1st 24 hrs. after shot

Gas Cu. Ft.

Dry Hole

Abandoned

Date **MAY 7 1923**

M. A. BENEAR

191 Scout

Map No. **KANSAS** 17 Sec. 9 Twp. 23 R. 13

Well No. 2 Schindler

Thuta Company

Contractor

ABANDONED SECTION PLAT

760 Ft. from N. Line

Ft. from S. Line

200 Ft. from E. Line

Ft. from W. Line

			0

Location

Rig up

Drilling and Remarks:

Tap Line 1777

40 x 0

2210'

RECORD

Cased _____ in., _____ ft.

Sand _____

Gas _____

Oil _____

Total Depth _____

PRODUCTION

1st 24 hrs. Nat. _____

1st 24 hrs. after shot _____

Gas _____ Cu. Ft.

Dry Hole _____

Abandoned _____

Date

NOV 24 1923

M. A. BENEAR

192

Scout