


Sedgwick **KANSAS**

Section 30 Township 27 Range 2E

Well No. #2 Morley

Company Eckland Drlg. et al

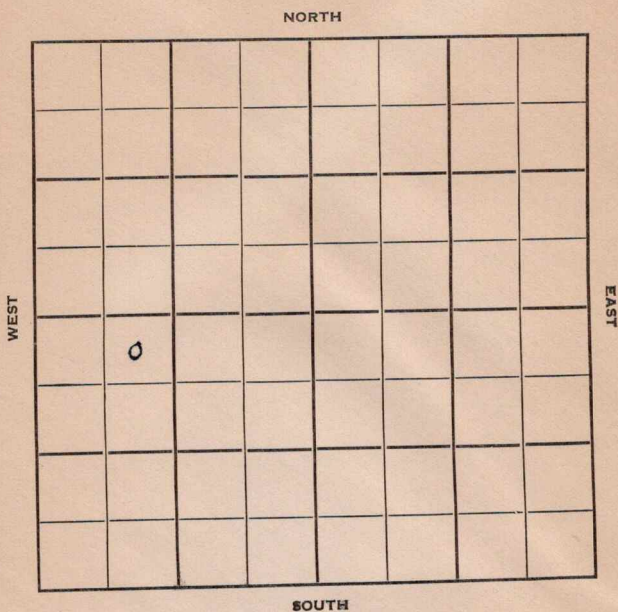

Sedgwick **KANSAS**

Sec. 30 Twp. 27 R. 2E

Well No. #2 Morley Farm

Eckland Drlg. et al Company

Eckland Drlg. - Contr. Contractor

Eastborough Pool


330' Ft. from N. Line

_____ Ft. from S. Line

_____ Ft. from E. Line

990' Ft. from W. Line

NE NW SW

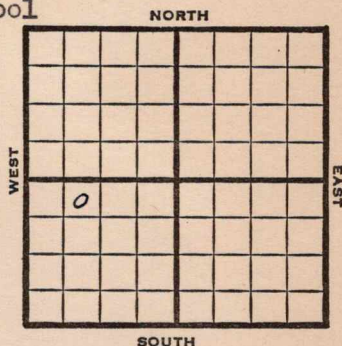

1950

Elev 1344

REPORT

10/4

Spud 9-28-50
8" @ 73'
Drlg. 2643'

10/25

8" @ 73

KC 2499

Miss 2962


DST 2970-86 TD opn 1 hr rec 200' mud & water

TD 2986

D&A

ABANDONED

County Sedgwick State Kansas
 Sec. 30 (Blk.) 27 (Sur.) 2E Map No.
 Operator Eckland Drlg. etal.
 Well No. 2 Farm Morley
 Elev. Location NE NW SW

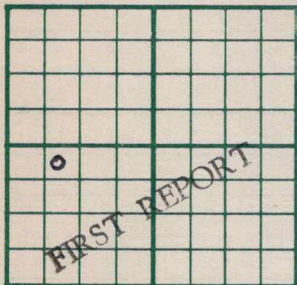

330 Ft. From N Line SW
990 Ft. From W Line Quarter
 1st. Report OCT 4 1950

Completion

Remarks

Eckland Drlg. - Contr.

Spudding Date 9-28-50

Drlg. Data

Eastborough Pool

8" @ 73 KC 2499 drlg. 2643

J. E. TYRA

County Sedgewick State Kansas

Sec. 30 (Blk.) 27 (Sur.) 2E Map No.

Operator Eckland Drlg. etal.

Well No. 2 Farm Morley

Elev.	1344	Location	NE NW SW
-------	------	----------	----------

330 Ft. From N Line SW

990 Ft. From W Line Quarter

1st. Report

Completion OCT 25 1950

Remarks	Eastborough Pool
---------	------------------

Eckland Drlg. - Contr.

Spudding Date 9-28-50

Drig. Data D & A TD 2986

8" @ 73 KC 2499 Miss. 2962

DST 2970-86 TD open 1 hr. Rec. 200'

Mud & water D & A