
Form 51 5M 2-22 8411

Map No. K16 Sec. 13 Twp. 23 R. 10

Well No. 1 Edwards Farm

White Eagle Company

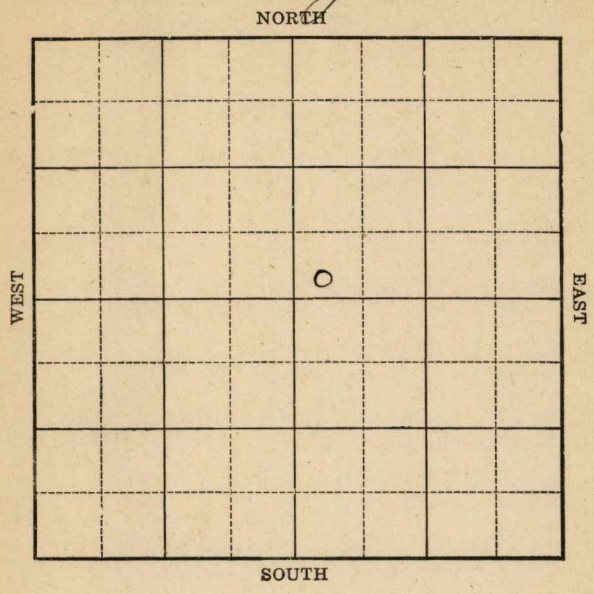

Location

Drilling Remarks:

Rig Up

Drilling Remarks:

RECORD

Cased in. ft.

Sand

Gas

Oil

Total Depth

PRODUCTION

1st 24 hrs. Nat.

1st 24 hrs. after shot

Gas cu. ft.

Dry Hole

Abandoned

Form 252A 5M 4-22 8765

Map No. 1 Sec. 13 Twp. 23 R. 10

Well No. Edwards Farm


White Eagle Company

____ Ft. from N. Line

330 Ft. from S. Line

____ Ft. from E. Line

330 Ft. from W. Line

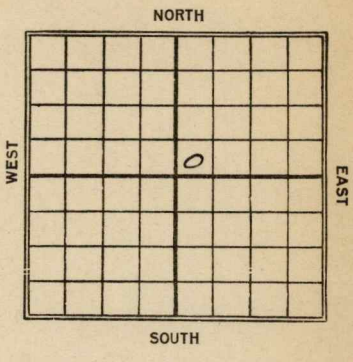

Date 1923	REPORT
11/24	Spud
1924	
1/18	2070 - 2111 - Shot 160 qts / Pump 215 Bbls
	IP 2131

Form 26—1M Bks.—3-23—11959.

Map No. KANSAS 16 Sec. 13 Twp. 23 R. 10


Well No. 1 E. Edwards

White Eagle Company

Contractor

FIRST REPORT

SECTION PLAT

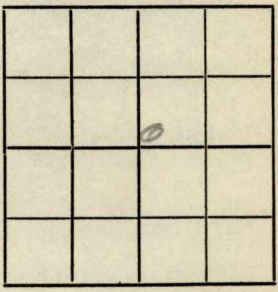

Ft. from N. Line

330 Ft. from S. Line

Ft. from E. Line

330 Ft. from W. Line

Location

Rig up

Drilling and Remarks:

Spud

RECORD

Cased in., ft.

Sand

Gas

Oil

Total Depth

PRODUCTION

1st 24 hrs. Nat.

1st 24 hrs. after shot

Gas Cu. Ft.

Dry Hole

Abandoned

Date

NOV 24 1923

192

M. A. BENEAR

Scout

Form 26—1M Bks.—3-23—11959.

Map No. KANSAS 16 Sec. 13 Twp. 23 R. 10


Well No. #1 Edwards

White Eagle O. & R. Company

Contractor

COMPLETED

SECTION PLAT

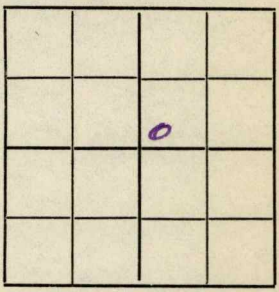

Ft. from N. Line

330 Ft. from S. Line

Ft. from E. Line

330 Ft. from W. Line

Location

Rig up

Drilling and Remarks:

sand 2070 - 2111
T.D. 2131'
shot 160 qts
pumping 215 bbls

RECORD

Cased in., ft.

Sand

Gas

Oil

Total Depth

PRODUCTION

1st 24 hrs. Nat.

1st 24 hrs. after shot

Gas Cu. Ft.

Dry Hole

Abandoned

Date JAN 18 1924

192

M. A. BENEAR Scout