


Section 9 Township 23 Range 13-E

Well No. #2 Schneider

Company Henderson Oil

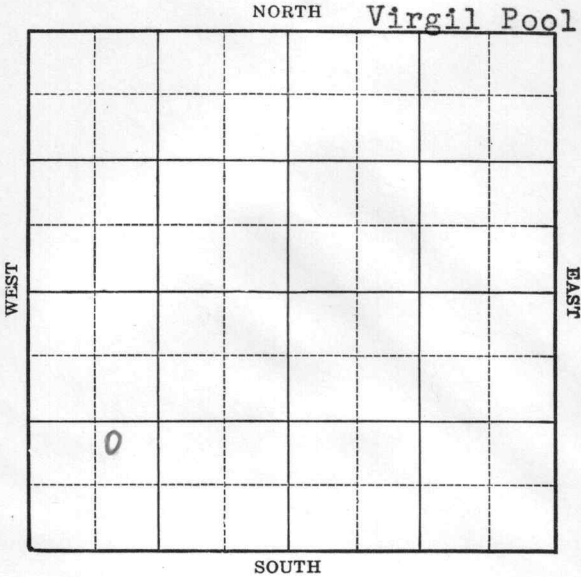

Map No. 17 Sec. 9 Twp. 23 R. 13EWell No. 2 Schneider

Henderson Oil

Company

Contractor

FIRST REPORT

NE SW SW

SECTION PLAT

o			

 Ft. from N. Line1155 Ft. from S. Line Ft. from E. Line850 Ft. from W. Line

VIRGIL POOL

Location Rig up

Drilling and Remarks:

Machine

RECORD

Cased in., ft.Sand Gas Oil Total Depth

PRODUCTION

1st 24 hrs. Nat. 1st 24 hrs. after shot Gas Cu. Ft.Dry Hole Abandoned

Date

JUL 24 1940 19

S. J. LEWIS Scout

Map No. 17 Sec. 9 Twp. 23 R. 13EWell No. 2 SchneiderHenderson Oil

Company

Contractor

COMPLETED

NE SW SW

 Ft. from N. Line1155 Ft. from S. Line Ft. from E. Line850 Ft. from W. Line

VIRGIL POOL

SECTION PLAT

Location Rig up

Drilling and Remarks:

*Nies 1745.**6" @ 1770**20000 ac. et**Pump 20 Pst.*

RECORD

Cased in., ft.Sand Gas Oil Total Depth 1779

PRODUCTION

1st 24 hrs. Nat. 1st 24 hrs. after shot Gas Cu. Ft.Dry Hole Abandoned

Date

SEP 4 1940 19

S. J. LEWIS Scout