
Form 51 5M 11-23 13896

Map No. _____ Sec. 13 Twp. 23 R. 10

Well No. 3 Edwards Farm

White Eagle Company

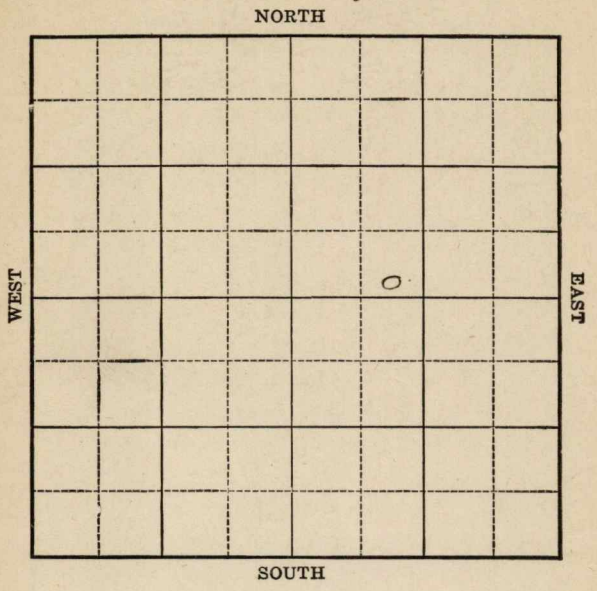

Location _____

Drilling Remarks:

Rig Up _____

Drilling Remarks:

RECORD

Cased _____ in. _____ ft.

Sand _____

Gas _____

Oil _____

Total Depth _____

PRODUCTION

1st 24 hrs. Nat. _____

1st 24 hrs. after shot _____

Gas _____ cu. ft.

Dry Hole _____

Abandoned _____

Form 252A 5M 4-22 8765

Map No. K Sec. 13 Twp. 23 R. 10

Well No. 3 Edwards Farm


White Eagle Company

____ Ft. from N. Line

300 Ft. from S. Line

____ Ft. from E. Line

990 Ft. from W. Line

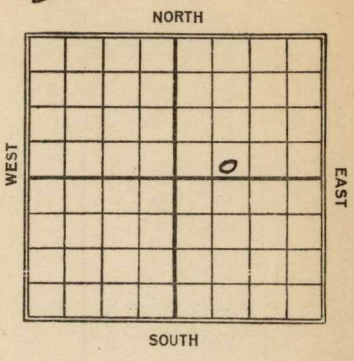

Date	REPORT
1924	
1/15	Rig up
2/27	Sand 2045-2087
	Sd. 2093
	Shot 160 qts/50 Bbls

Form 26—1M—4-19—Mid-West

Map No. KANSAS Sec. 16 13 Twp. 23 R. 10


Well No. 3 Edwards

White Eagle Company

Contractor

FIRST REPORT

SECTION PLAT

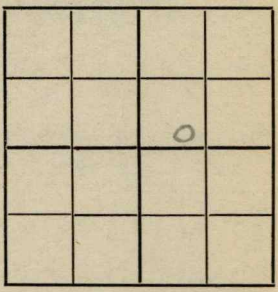

300 Ft. from N. Line

Ft. from S. Line

Ft. from E. Line

990 Ft. from W. Line

Location

Rig up

Drilling and Remarks:

RECORD

Cased in., ft.

Sand

Gas

Oil

Total Depth

PRODUCTION

1st 24 hrs. Nat.

1st 24 hrs. after shot

Gas Cu. Ft.

Dry Hole

Abandoned

Date

JAN 15 1924 191

M. A. BENEAR Scout

Form 26—1M Bks.—3-23—11959.

Map No. KANSAS 16 Sec. 13 Twp. 23 R. 10


Well No. 3 Edwards

White Eagle O & R Company

Contractor

COMPLETED

SECTION PLAT

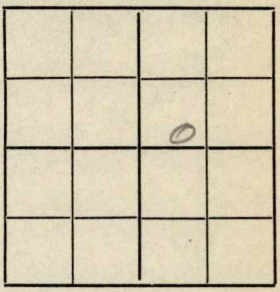

---Ft. from N. Line

330 Ft. from S. Line

---Ft. from E. Line

990 Ft. from W. Line

Location

Rig up

Drilling and Remarks:

Sand 2045-2087

TD 2093

160/50 bbls.

RECORD

Cased ---in., --- ft.

Sand

Gas

Oil

Total Depth

PRODUCTION

1st 24 hrs. Nat.

1st 24 hrs. after shot

Gas ---Cu. Ft.

Dry Hole

Abandoned

Date

FEB 27 1924

---192---.

M. A. BENEAR

---Scout