

Map No. _____ Sec. 13 Twp. 23 R. 10
Well No. 3 Edwards Farm _____
Phillips Pet. Company _____

NORTH

WEST

EAST

SOUTH

Location _____

Drilling Remarks:

Rig up _____

Drilling Remarks:

RECORD

Cased _____ in. _____ ft.

Sand _____

Gas _____

Oil _____

Total Depth_____

PRODUCTION

1st 24 hrs Nat. _____

1st 24 hrs. after shot_____

Gas _____ cu. ft.

Dry Hole_____

Abandoned _____

Map No. _____ Sec. 13 Twp. 23 R. 10


Well No. 3 Edwards Farm _____
Phillips Pet. Company _____

_____ Ft. from N. Line

990 Ft. from S. Line

_____ Ft. from E. Line

330 Ft. from W. Line

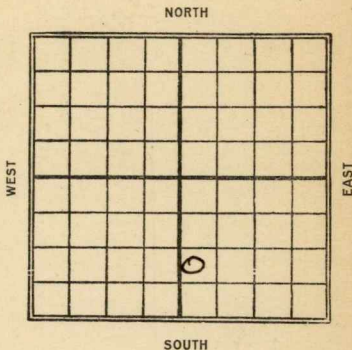

Date
1923
1/26
4/20

REPORT

Location.
Sand 2030 - 96 - Shot
200 lbs. 75 Bbls. J-D-2098'

Map No. KANSAS Sec. 13 Twp. 23 R. 10
Well No. 3 Edwards
Phillips Pet Company
Contractor

FIRST REPORT

Ft. from N. Line
990' Ft. from S. Line
Ft. from E. Line
330' Ft. from W. Line

SECTION PLAT

Location ✓
Rig up
Drilling and Remarks:

RECORD

Cased _____ in., _____ ft.
Sand _____
Gas _____
Oil _____
Total Depth _____

PRODUCTION

1st 24 hrs. Nat. _____
1st 24 hrs. after shot _____
Gas _____ Cu. Ft.
Dry Hole _____
Abandoned _____

Date JAN 26 1923

M. A. BENEAR

Map No. **KANSAS** Sec. **13** Twp. **23** R. **10**
 Well No. **3 Edwards**
Phillips Pet Company

Contractor

COMPLETED

SECTION PLAT

Ft. from N. Line

990

Ft. from S. Line

Ft. from E. Line

330

Ft. from W. Line

RECORD

Location

Cased _____ in., _____ ft.

Rig up

Sand _____

Drilling and Remarks:

Gas _____

Oil _____

Total Depth _____

PRODUCTION

1st 24 hrs. Nat. _____

1st 24 hrs. after shot _____

Gas _____ Cu. Ft.

Dry Hole _____

Abandoned _____

Date

APR 20 1923**M. A. BENEAR**

191

Scout