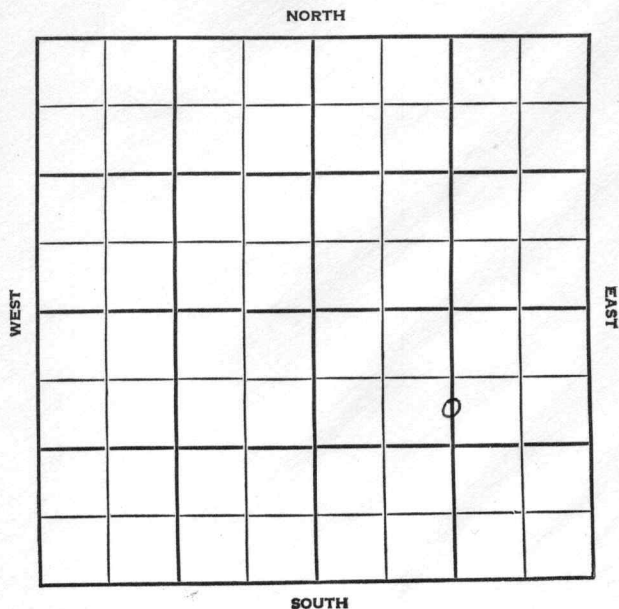


Section 9 Township 23 Range 13EWell No. #3 SchneiderCompany Elmer Schneider et al

Greenwood KANSAS

SEC.	TWP.	R.
9	23	13E

WELL NO.

3 Schneider

FARM

COMPANY

Elmer Schneider et al

CONTRACTOR

Brown

N. Virgil Pool

1000


Ft. from N. Line

Ft. from S. Line

1200

Ft. from E. Line

Ft. from W. Line

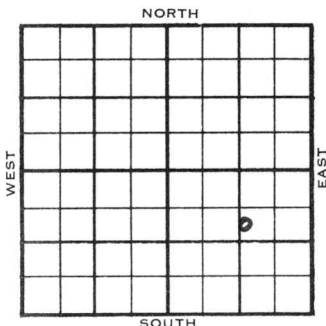

C S/2 N/2 SE

1954

ELEVATION

REPORT


11/3
12/22

Location

Spud 11-16-54 Oil well TD 1805
10" @ 629 8-5/8" @ 928 7" @ 1410
Miss 1783 TD 1805 5" @ 1790
CO to 1805 FU 250! oil 500 A
P/6 BOPH Comp. 60 BOPD

COMPLETED


County Greenwood State Kansas
 Sec. 9 (Blk. 23 (Sur. 13E Map No.
 (Twp. (Rge.
 Operator Elmer Schneider etal.
 Well No. 3 Farm Schneider
 Elev. Location C S $\frac{1}{2}$ N $\frac{1}{2}$ SE

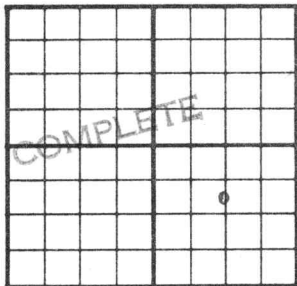

1000 Ft. From N Line SE
1200 Ft. From E Line Quarter
 1st. Report
 Completion DEC 22 1954
 Remarks N. Virgil Pool
Brown - Contr.
 Spudding Date 11-16-54

Drlg. Data Oil well TD 1805
10" @ 629 8 5/8" @ 928 7" @ 1410
Miss. 1783 TD 1805 5" @ 1790
CO to 1805 FU 250' oil 500 A
P/ 6 boph Comp. 60 bopd

FABEN GILSTRAP

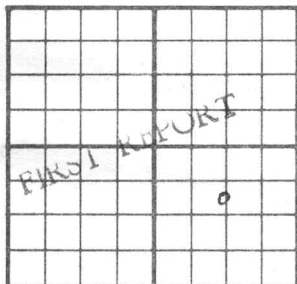County Greenwood State KansasSec. 9 (Blk.) 23 (Sur. Rge.) 13E Map No.Operator Elmer Schneider et al.Well No. 3 Farm SchneiderElev. Location C S $\frac{1}{2}$ N $\frac{1}{2}$ SE1000 Ft. From N Line SE1200 Ft. From E Line Quarter1st. Report NOV 3 1954

Completion

Remarks

Brown - Contr.

Spudding Date

Drlg. Data H. Virgil PoolLocation

FABEN GILSTRAP