
Greenwood KANSAS

SECTION 9 TOWNSHIP 23 RANGE 13E

WELL NO. #4 Schneider

COMPANY J. F. Schneider et al

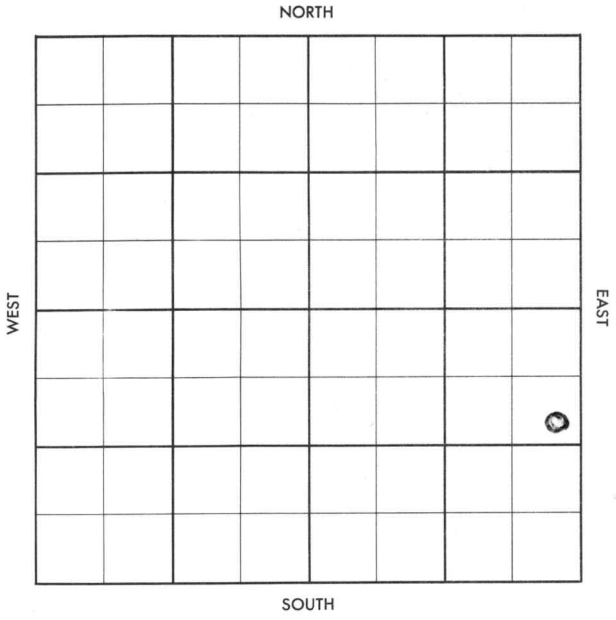

KANSAS

Greenwood

SEC.	TWP.	R.
9	23	13E

WELL NO.

#4 Schneider FARM

COMPANY

J.F. Schneider etal

CONTRACTOR

S.V. Brown

N. Virgil


_____ Ft. from N. Line

_____ Ft. from S. Line

_____ Ft. from E. Line

_____ Ft. from W. Line

SE NE SE

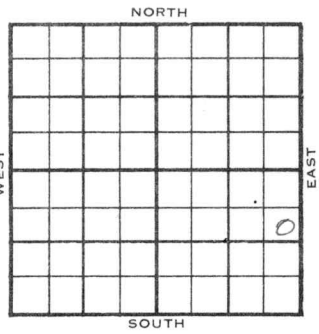

1956	ELEVATION REPORT
4-18	Location
5-23	Comm. 4-22-56 8 5/8" @ 965 7" @ 1599 Reaming @ 1620 4½" @ 1775 CO 1785 S/ 5 to 6 BO in 8 hrs. P/ 15 BOPD + 60 % wtr. Bartl. 1599', M. Li. 1780', TD 1785'. COMPLETED

DX-78

FORM 513 SUNRAY

County Greenwood Elev.

Sec. 9 Twp. 23 Rge. 13E

Company J. F. Schneider etal.

Farm Name Schneider No. 1

TOPS	DEPTH	LOG	DATUM
Anh.			
Tp.			
H.			
Tr.			
Dg. Bartl.	1599		
Bl.			
L.			
K.C.			
B.K.C.			
Ce.			
C.			
M. L.	1780		
M.			
K.			
Mz.			
Mo.			
V.			
S.			
S.			
A			
R.			
P€.			
G.			
T.D.	1785		

Loc. in Sec. SE NE SE

Geol.

Contr. S. V. Brown

Pool N. Virgil

COMPLETE

Date Comm. MAY 23 1956

Location APR 25 '56 4-22-56 P 130

MAY 2 '56 8 5/8 @ 965 MAY 9 '56 7" @ 1599 Ream @ 1620 MAY 18 '56

MAY 23 '56 4½ @ 1775 CO 1785 A

F 5 To 6 Bo in 8 hrs Pot.

P. 15 Bopd + 60 % wtr

Co. Lse. No. Sec. T. R.

FORM 513 SUNRAY

County Greenwood Elev.

Sec. 9 Twp. 23 Rge. 13E

Company J. F. Schneider etal.

Farm Name Schneider No. 4

TOPS	DEPTH	LOG	DATUM
Anh.			
Tp.			
H.			
Tr.			
Dg.			
Bl.			
L.			
K.C.			
B.K.C.			
Ce.			
C.			
M.			
M.			
K.			
Mz.			
Mo.			
V.			
S.			
S.			
A			
R.			
P€.			
G.			
T.D.			

Loc. in Sec. SE NE SE

Geol.

Contr. S.V. Brown

Pool N. Virgil

FIRST REPORT

APR 18 '55

Date Comm.

Location

Co.

Lse.

No.

Sec.

T.

R.