


Sedgwick
 Map No. **KANSAS** Sec. *38* Twp. *27* R. *25*
 Well No. *1-25* Farm
Pickens & Finkle Company

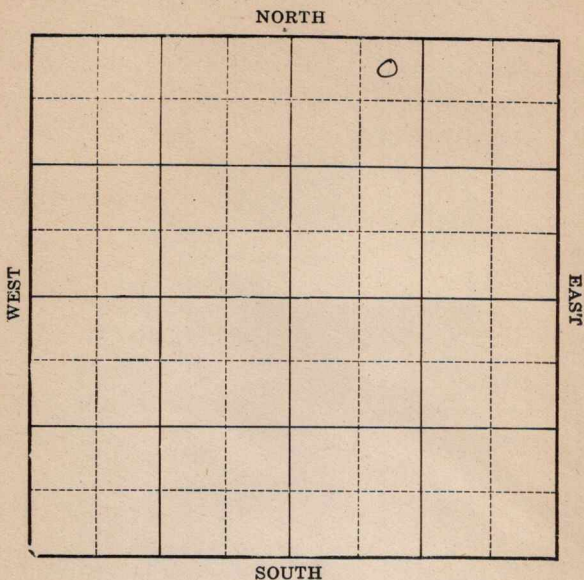

Location _____

Drilling Remarks _____

Rig Up _____

Drilling Remarks _____

RECORD

Cased _____ in. _____ ft.

Sand _____

Gas _____

Oil _____

Total Depth _____

PRODUCTION

1st 24 hrs. Nat. _____

1st 24 hrs. after shot _____

Gas _____ cu. ft.


Dry Hole _____

Abandoned _____

Map No. **KANSAS** Sec. 30 Twp. 27 R. 2E

Well No. 1- Reys Farm Vickers & Finkle Company

NORTH

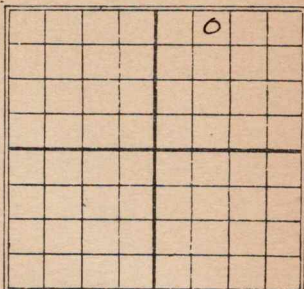

SOUTH

330 Ft. from N. Line

_____ Ft. from S. Line

_____ Ft. from E. Line

990 Ft. from W. Line

1930

Date

REPORT

5/14	Ro G
5/21	Bldg rig
5/28	Rig & dng. water well.
6/4	Spud
6/11	dng. 900'
6/18	" 1750'
6/25	" 2400'
7/2	8" - 2575'
	Slg. out 2580'
7/9	Shot 2935
	T.D. 2967
	1400' oil
7	
7/21	For Pay 3238'
	TD 32402' Hole filled up in 2 hours and stopping over 4 bbls an hour - Think is Wilcox sand

758242

7/23 - Wilcox 3238-42

swabbed 552

bbls 12 hrs. 40.9

gravity

7/30 - Wilcox 3238-42'

TD 3242

flow & swap 1016 gal
Comp.

Scotgwick
 Map No. **KANSAS** Sec. *30* Twp. *27* R. *2E*

Well No. *1 Keys*

Vickrey & Hinkle Company

Contractor

SECTION PLAT

320 Ft. from N. Line

Ft. from S. Line

Ft. from E. Line

990 Ft. from W. Line

		0	

FIRST REPORTS

Location

Rig up

Drilling and Remarks:

ROG

RECORD

Cased in, ft.

Sand

Gas

Oil

Total Depth

PRODUCTION

1st 24 hrs. Nat.

1st 24 hrs. after shot

Gas Cu. Ft.

Dry Hole

Abandoned

Date

MAY 14 1930

192

S. J. LEWIS Scout

Bedgwick 12
 Map No. **KANSAS** Sec. 30 Twp. 27 R. 25

Well No. 1 Key

Vickers & Hinkle Company

Contractor

SECTION PLAT

		0	

330 Ft. from N. Line

_____ Ft. from S. Line

_____ Ft. from E. Line

990 Ft. from W. Line

COMPLETED

Location _____

Rig up _____

Drilling and Remarks:

Wilcox 3238--42

Flint & Swath.

1016 ft.

RECORD

Cased _____ in., _____ ft.

Sand _____

Gas _____

Oil _____

Total Depth 3242

PRODUCTION

1st 24 hrs. Nat. _____

1st 24 hrs. after shot _____

Gas _____ Cu. Ft.

Dry Hole _____

Abandoned _____

Date

JUL 30 1930

19

S. J. LEWIS Scout