

NORTH

WEST

EAST

SOUTH

Drilling Remarks

Drilling Remarks

RECORD

Total Depth -----

PRODUCTION


Abandoned.....

Map No. **KANSAS** Sec. 30 Twp. 27 R. 2^E

Well No. 2-Keys Farm

Vickers Pet Company

NORTH

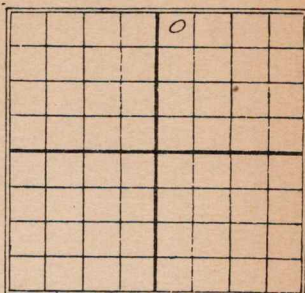

330 Ft. from N. Line

_____ Ft. from S. Line

_____ Ft. from E. Line

330 Ft. from W. Line

1930

SOUTH

Date

REPORT

7/2	Prod.
7/9	Spud
7/16	Relg. 750'
7/23	" 1875'
7/30	" 2600'
8/6	Tap Chat 2942-74
	350' wire
8/13	Chat 2942-78
	TO 2978
	swab 271 bbl oil
	Comp.

Sealgwick
 Map No. **KANSAS** Sec. 30 Twp. 27 R. 2E

Well No. 2 Keys

Vickers A & S Company

Contractor

SECTION PLAT

		0	

330 Ft. from N. Line

_____ Ft. from S. Line

_____ Ft. from E. Line

330 Ft. from W. Line

FIRST REPORTS

Location _____

Rig up _____

Drilling and Remarks:

ROG

RECORD

Cased _____ in., _____ ft.

Sand _____

Gas _____

Oil _____

Total Depth _____

PRODUCTION

1st 24 hrs. Nat. _____

1st 24 hrs. after shot _____

Gas _____ Cu. Ft.

Dry Hole _____

Abandoned _____

Date

JUL 2 1930

19

S. J. LEWIS Scout

Bedgwick
 Map No. **KANSAS** Sec. 30 Twp. 27 R. 2E

Well No. 2 Meyer

Vickers P & S. Company

Contractor

SECTION PLAT

		0	

830 Ft. from N. Line

_____ Ft. from S. Line

_____ Ft. from E. Line

830 Ft. from W. Line

COMPLETED

Location _____

Rig up _____

Drilling and Remarks:

Chas 2942-78

swat 2718th

RECORD

Cased _____ in., _____ ft.

Sand _____

Gas _____

Oil _____

Total Depth 2978

PRODUCTION

1st 24 hrs. Nat. _____

1st 24 hrs. after shot _____

Gas _____ Cu. Ft.

Dry Hole _____

Abandoned _____

Date

AUG 13 1930

19

S. J. LEWIS

Scout