O.W.W.O. Barton KANSAS.

FORM 51 25M 3-49 PETROL

Section 11 Township 19 Range 12W

Well No. #1 Miller

Company ~~J. C. Dozier~~ LEWIS DRLG.

Wildcat

O.W.W.O.

6

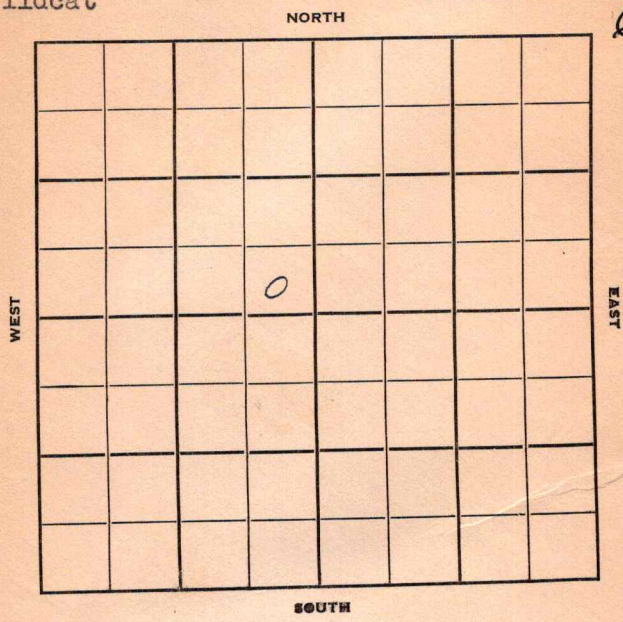

FORM 252-A
5M 10-48 PETROL

O.W.W.O.

Barton KANSAS

Sec. 11 Twp. 19 R. 12W

Well No. #1 Miller Farm

LEWIS DRLG.
~~J. C. Dozier~~ Company

Wildcat (Lewis Drlg. Contr.)

_____ Ft. from N. Line

330' Ft. from S. Line

330' Ft. from E. Line

_____ Ft. from W. Line

SE NW

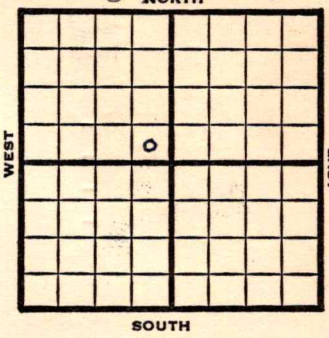

1949	Elev 1818' REPORT
12/21	RUR
12/28	Surface hole
1950	
2/15	TD 3403' 5"@ 3377' Lans 3104' Arb. 3374' Set plug at 3300 in Lans Perf 24/3295-99 129 BOPD Comp

COMPLETED

O.W.W.O.

1950	
4/5	Lans. 3104' Arb 3374' 5" @ 3377' TD 3405' Set plug 3286 26/3151-56 SO 26/3126-35 SSO 24/3100-08 SSO 20/3166-73 3/4 bbl. oil 3000 acid Flow 76 BO 1 hr Flow 100 BO then stopped To reacidize.

OVER

1950

4/26 TD 3405'
Lans 3104
Arb. 3374'
5"@ 3377'
TD 3405'
Set plug 3286'
26/3151-56 SO
26/3126-35 SSO
24/3100-08 SSO
20/3166-73
3000 A
1500 A
Flow 180 BOPD
Comp 180 BOPD
Comp

COMPLETED

1952
9/4 Heeb. 2967 Br. Li 3083 **O.W.W.O.**
Lans. 3104 Arb. 3374
OTD 3403 5" @ 3377 PB 3201
Perf. 3100-73 500 A Sq. 3100-73
DP 3141 63/ 3126-36 3000 A

9/10 Oil Well TD 3403
Heeb. 2967 Br Lime 3083 Lans. 3104
Arb. 3374 OTD 3403 5" @ 3377
PB 3201 Perf/3100-73 500A
Sq. 3100-73 DP 3141 63/3126-36
3000 A S/½ bo ½ bwph PB 3119
27/3110-14 15 go 5 gwph
24/3102-06 2500 A S/1 bo
3/4 bwph DP 3336 P/33 bo
Comp. 33 bopd

COMPLETED

Form 26 200 Bks. 6-49 Petrol

Kansas

Wildcat

Map No. _____ Sec. 11 Twp. 19 R. 12W

Well No. 1 Miller

J. C. Dozier Company

Lewis Drlg. Contractor

SE NW

FIRST REPORT

SECTION PLAT

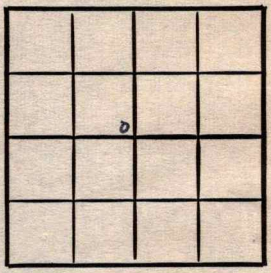

_____ Ft. from N. Line

330 Ft. from S. Line

330 Ft. from E. Line

_____ Ft. from W. Line

Barton County

Location _____

Rig up _____

Drilling and Remarks:

R U R

RECORD

Cased _____ in., _____ ft.

Sand _____

Gas _____

Oil _____

Total Depth _____

PRODUCTION

1st 24 hrs. Nat. _____

1st 24 hrs. after shot _____

Gas _____ Cu. Ft.

Dry Hole _____

Abandoned _____

Date

DEC 21 1949 19

S. J. LEWIS Scout

Form 26 200 Bks. 11-49 Petrol

Kansas

Map No. ____ Sec. 11 Twp. 19 R. 12W

Well No. 1 Miller

J. C. Dozier Company

Contractor

SE SE NW

El. 1818

SECTION PLAT

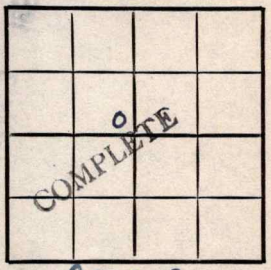

____ Ft. from N. Line

330 Ft. from S. Line

330 Ft. from E. Line

____ Ft. from W. Line

Barton County

Owwo

Location

Rig up

Drilling and Remarks:

Lans. 3104
Arb. 3374
5" @ 3377
T.D. 3405
Set plug 3286
26/ 3151-56 SO
26/ 3126-35 SSO

RECORD

Cased ____ in., ____ ft.

Sand

Gas

Oil

Total Depth 3405

PRODUCTION

1st 24 hrs. Nat.

1st 24 hrs. after shot

Gas ____ Cu. Ft.

Dry Hole

Abandoned

Date

APR 26 1950 19

J. E. TYRA Scout

24/3100-08 SSO
20/3166-73
3000 A
1500 A
7 low 180 boyd
Comp. 180 boyd

MAY 3 1950

Scout Cards
Land Small Map
Land Wall Map
Tracings
France Map
Pierce Map
Misc.

Form 26 200 Bks. 11-49 Petrol

Wildcat

Kansas

Map No. _____ Sec. 11 Twp. 19 R. 12W

Well No. 1 Miller

J. C. Dozier Company

Contractor

SE NW

El. 1818

SECTION PLAT

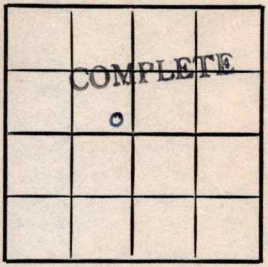

_____ Ft. from N. Line

330 Ft. from S. Line

330 Ft. from E. Line

_____ Ft. from W. Line

Barton County

Location _____

Rig up _____

Drilling and Remarks:

5" @ 3377
Lans 3104
anh 3374
Set plug at
3300 in Lans
perf 24/3295-99

RECORD

Cased _____ in., _____ ft.

Sand _____

Gas _____

Oil _____

Total Depth 3403

PRODUCTION

1st 24 hrs. Nat. _____

1st 24 hrs. after shot _____

Gas _____ Cu. Ft.

Dry Hole _____

Abandoned _____

Date 129 BOPD

FEB 15 1950

19

J. E. TYRA

Scout

Form 26 200 Bks. 11-49 Petrol

Kansas

OWWO

Map No. _____ Sec. 11 Twp. 19 R. 12W

Well No. 1 Miller

J. C. Dozier Company

Contractor

SE SE NW

O.W.W.O. El. 1818

SECTION PLAT

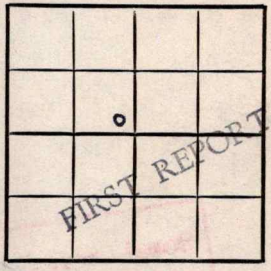

_____ Ft. from N. Line

330 Ft. from S. Line

330 Ft. from E. Line

_____ Ft. from W. Line

Barton County

Location _____

Rig up _____

Drilling and Remarks:

Lans. 3104
Arb. 3374
5" @ 3377
TD 3405
set plug 3286
26/3151-56 SO

RECORD

Cased _____ in., _____ ft.

Sand _____

Gas _____

Oil _____

Total Depth _____

PRODUCTION

1st 24 hrs. Nat. _____

1st 24 hrs. after shot _____

Gas _____ Cu. Ft.

Dry Hole _____

Abandoned _____

Date

APR 5 1950 19

J. E. TYRA Scout

26/3126-35 SSO

24/3100-08 SSO

20/3166-73 3/4 bbl. oil

3000 acid

flow 76 bo 1 hr.

flow 100 bo then stopped

to reacidize

FORM 275 FOR SALE BY KANSAS BLUE PRINT CO.

O.W.W.O.

County Barton State Kansas

Sec. 11 (Blk. Twp.) 19 (Sur. Rge.) 12W Map No.

Operator Lewis Drlg.

Well No. 1 Farm Miller

Elev. Location SE SE NW

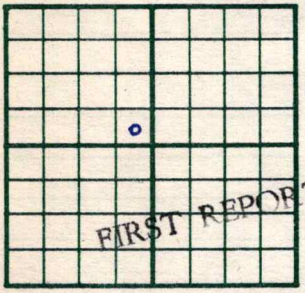

330 Ft. From S Line NW

330 Ft. From E Line Quarter

1st. Report SEP 4 1952

Completion O.W.W.O.

Remarks OWWO

Spudding Date O.W.W.O.

Drlg. Data

Heeb. 2967 Br. lime 3083 Lans. 3104

Arb. 3374 OTD 3403 5" @ 3377 PB 3201

Perf/ 3100-73 500 A sq. 3100-73 DP 3141

63/ 3126-36 3000 A

J. G. McGEHEE

FORM 275 FOR SALE BY KANSAS BLUE PRINT CO.

County Barton State Kansas

Sec. 11 (Blk. Twp.) 19 (Sur. Rge.) 12W Map No.

Operator Lewis Drlg.

Well No. 1 Farm Miller

Elev. Location SE S E NW

330 Ft. From S Line NW

330 Ft. From E Line Quarter

1st. Report

Completion SEP 1 0 1952

Remarks OWWO

Spudding Date

Drlg. Data Oil well TD 3403

Heeb. 2967 Br. lime 3083 Lans. 3104

Arb. 3374 OTD 3403 5" @ 3377 PB 3201

Perf/ 3100-73 500 A sq. 3100-73

DP 3141 63/ 3126-36 3000 A S/ ½ bo

½ bwph PB 3119 27/ 3110-14 15 go

5 gwph 24/ 3102-06 2500 A S/ 1 bo

3/4 bwph DP 3336 P/ 33 bo

Comp. 33 bopd

J. G. McGEHEE