

Map No. 30 Sec. 27 Twp. 2 R. E

Well No. 1 Farm Mackey

W. H. Marland, Inc. Company

PRODUCERS & REFINERS of oil

WEST

EAST

SOUTH

OWDD

Location.....

Drilling Remarks

Rig Up.....

Drilling Remarks

RECORD

Cased..... in..... ft.

Sand.....

Gas.....

Oil.....

Total Depth.....

PRODUCTION

1st 24 hrs. Nat.....

1st 24 hrs. after shot.....

Gas..... cu. ft.....

Dry Hole.....

Abandoned.....

Map No. **KANSAS** Sec. 30 Twp. 27 R. 2^E

Well No. 1-Mackay Farm

~~W. Marland & Co.~~ Company

PRODUCERS & REFINERS ~~etc.~~


990 Ft. from N. Line

_____ Ft. from S. Line

_____ Ft. from E. Line

990 Ft. from W. Line

1929

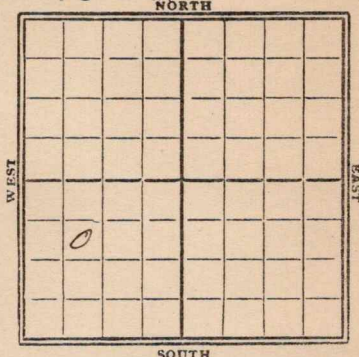

Date	REPORT
5/29	Location
6/5	
6/12	Bldg Rig
6/19	Rig on up
6/26	well 525'
7/2	" 710'
7/10	" 1440'
7/17	S.D. 1440'
7/24	drly by pipe 1440 TD.
7/31	well 1490'
8/7	" 1700'
8/14	" 2330'
8/21	will not give information
8/21	Show oil 2655-60
	well 2863'
9/4	200 chat 2956 B. Chat 2957
	Swabbed 22 hbls oil
	7 hrs 2964-66 - TD
	1000' water
9/11	T.D. 2970' pump 70 hbls
	50 hbls water
9/18	

9/25- Chat 2956-70'

T.D. 2970'

Pump 72 bbl oil
35 " water
Comp.

1930

OWDD

8/13- Old TD 2970

Rgn up.

8/20- drlg 2983'

8/27- 37½ bbl oil

80 water 2983'

9/3- No report

9/10- Sand 2956-83

T.D. 2983

Pump 37½ bbl oil
and 80 " water
Comp.

Map No. **KANSAS** Sec. 30 Twp. 27 R. 2E

Well No. Mackey

E. H. Mackey & Son Company

Contractor

SECTION PLAT

990 Ft. from N. Line

..... Ft. from S. Line

..... Ft. from E. Line

990 Ft. from W. Line

6			

FIRST REPORTS

Location ✓

Rig up

Drilling and Remarks:

RECORD

Cased in., ft.

Sand

Gas

Oil

Total Depth

PRODUCTION

1st 24 hrs. Nat.

1st 24 hrs. after shot

Gas Cu. Ft.

Dry Hole

Abandoned

Date

MAY 29 1929

192

S. J. LEWIS Scout

Map No. **KANSAS** Sec. 30 Twp. 27 R. 25

Well No. 1 Mac key

E. W. Harland Inc Company

Contractor

SECTION PLAT

990 Ft. from N. Line

..... Ft. from S. Line

..... Ft. from E. Line

990 Ft. from W. Line

COMPLETED

Location.....

Rig up.....

Drilling and Remarks:

Chat 2956-2970

Pump 72 ft soil
35" water

RECORD

Cased.....in.,ft.

Sand.....

Gas.....

Oil.....

Total Depth 2970

PRODUCTION

1st 24 hrs. Nat.....

1st 24 hrs. after shot.....

Gas.....Cu. Ft.

Dry Hole.....

Abandoned.....

Date

SEP 25 1929

192.....

S. J. LEWIS

Scout

Seelywick
 Map No. **KANSAS** Sec. *80* Twp. *27* R. *2E*

12
 Well No. *Mac Kay*

Producers & Ref Edab Company

Contractor

SECTION PLAT

990 Ft. from N. Line

_____ Ft. from S. Line

_____ Ft. from E. Line

990 Ft. from W. Line

6 W 77
 Location _____

Rig up _____

Drilling and Remarks:

Rigging up.
Old 2970

RECORD

Cased _____ in., _____ ft.

Sand _____

Gas _____

Oil _____

Total Depth _____

PRODUCTION

1st 24 hrs. Nat. _____

1st 24 hrs. after shot _____

Gas _____ Cu. Ft.

Dry Hole _____

Abandoned _____

Date

AUG 13 1930

19

S. J. LEWIS Scout

Map No. **KANSAS** Sec. 30 Twp. 27 R. 2E

Well No. 1 Mac Key

Producers & Key & Co. Company

Contractor

SECTION PLAT

990 Ft. from N. Line

..... Ft. from S. Line

..... Ft. from E. Line

990 Ft. from W. Line

0	0		

COMPLETED

Location.....

Rig up.....

Drilling and Remarks:

*Pump 37 1/2" oil
" 80 " water*

RECORD

Cased..... in., ft.

Sand 2956-83

Gas.....

Oil.....

Total Depth 2983

PRODUCTION

1st 24 hrs. Nat.....

1st 24 hrs. after shot.....

Gas..... Cu. Ft.

Dry Hole.....

Abandoned.....

Date

SEP 10 1930

192

S. J. LEWIS

Scout