


Section 11 Township 19 Range 12W

Well No. #2 Ahrens

Company Aladdin Pet.

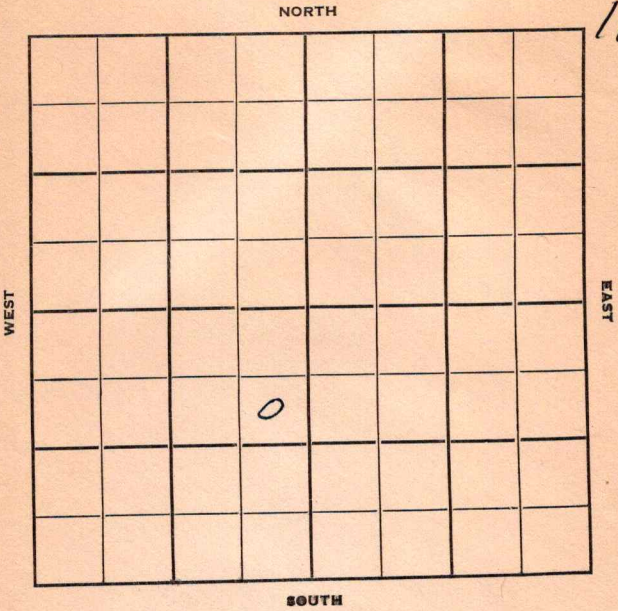

Barton

KANSAS

Sec. 11 Twp. 19 R. 12W

Well No. #2 Ahrens Farm

Aladdin Pet. Company

Contractor


990' Ft. from N. Line

_____ Ft. from S. Line

330' Ft. from E. Line

_____ Ft. from W. Line

SE NE SW

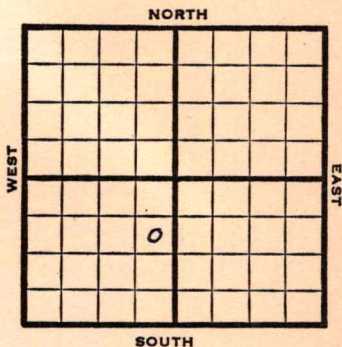

1950

Elev. 1835' REPORT

5/3 Location

6/14 8" @ 655

Anhy 645

Lans. 3117

Arb. 3380

5" @ 3384

24/3181-89, 24/3156-62

45/3129-44, 39/3112-25

3000 acid

Compl. 1055 bopd

29 Gravity

Completed

COMPLETED

Kansas

Map No. _____ Sec. 11 Twp. 19 R. 12W

Well No. 2 Ahrens

Aladdin Pet. Company

Contractor

SE NE SW

E. 1835
SECTION PLAT

990 Ft. from N. Line

_____ Ft. from S. Line

330 Ft. from E. Line

_____ Ft. from W. Line



Barton County

Location X

Rig up _____

Drilling and Remarks:

RECORD

Cased _____ in., _____ ft.

Sand _____

Gas _____

Oil _____

Total Depth _____

PRODUCTION

1st 24 hrs. Nat. _____

1st 24 hrs. after shot _____

Gas _____ Cu. Ft.

Dry Hole _____

Abandoned _____

Date

MAY 3 1950 19 J. E. TYRA Scout

Kansas

Map No. _____ Sec. 11 Twp. 19 R. 12W

Well No. 2 Ahrens

Aladdin Pet. Company

Contractor

SE NE SW

El. 1835

SECTION PLAT

990 Ft. from N. Line

_____ Ft. from S. Line

330 Ft. from E. Line

_____ Ft. from W. Line



Barton County

Location _____

Rig up _____

Drilling and Remarks:

8" @ 655

Anhy 645

Lans. 3117

Arb. 3380

5" @ 3384

24/ 3181-89

24/ 3156-62

RECORD

Cased _____ in., _____ ft.

Sand _____

Gas _____

Oil _____

Total Depth _____

PRODUCTION

1st 24 hrs. Nat. _____

1st 24 hrs. after shot _____

Gas _____ Cu. Ft.

Dry Hole _____

Abandoned _____

Date

JUN 14 1950 19

J. E. TYRA Scout

