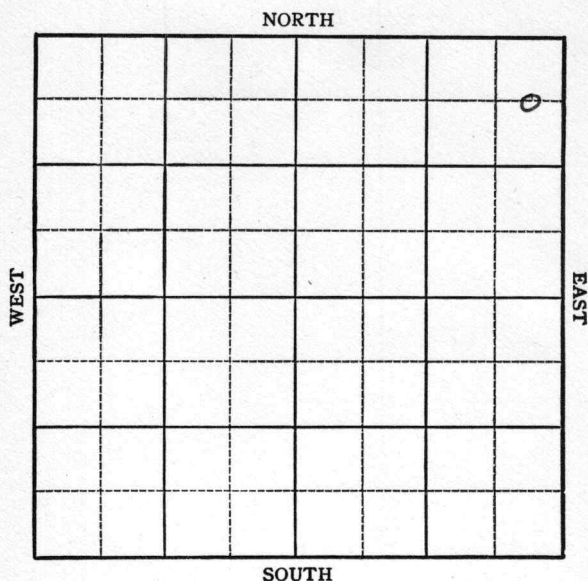


KANSASSection 9 Township 23S Range 13EWell No. #28 ImthurnCompany Shaffer & Howell

Greenwood **KANSAS**
Sec. 9 Twp. 23 R. 13E ✓

Well No. #28 Imthurn Farm

Shaffer & Howell Company

Miscellaneous (Brown, Cont.) NORTH


660' Ft. from N. Line

 Ft. from S. Line

330' Ft. from E. Line

 Ft. from W. Line

C E L NE NE

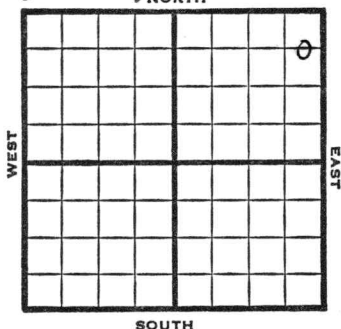

1949

REPORT

8/31

13" @ 575'

10" @ 890'

6" @ 1440'

Bart 1540'

40 qts. 1540-66

D&A TD 1566'

FIRST REPORT

ABANDONED

Map No. 517 Sec. 9 Twp. 23 R. 13E

Well No. 28 Imthurn

Shaffer & Howell

Company

Brown

C E L N E N E

~~FIRST REPORT~~ Contractor

~~SECTION PLAT~~

~~ABANDONED~~

660 Ft. from N. Line

Ft. from S. Line

330 Ft. from E. Line

Ft. from W. Line

Greenwood County

RECORD

Location

Cased _____ in., _____ ft.

Rig up

Sand _____

Drilling and Remarks:

Gas _____

13" @ 575

Oil _____

10" @ 890

Total Depth 1566

6" @ 1440

Bart. 1540

40 qts. 1540-66

D & A

PRODUCTION

1st 24 hrs. Nat. _____

1st 24 hrs. after shot _____

Gas _____ Cu. Ft.

Dry Hole _____

Abandoned _____

Date

AUG 31 1949 19

S. J. LEWIS

Scout