


BARTON

Form 51-5M-3-35-Mid-West

Map No. KANSAS Sec. 25 Twp. 19 R. 11-W

Well No. 1-M.Isern Farm
Sinclair-Prairie Company

NORTH

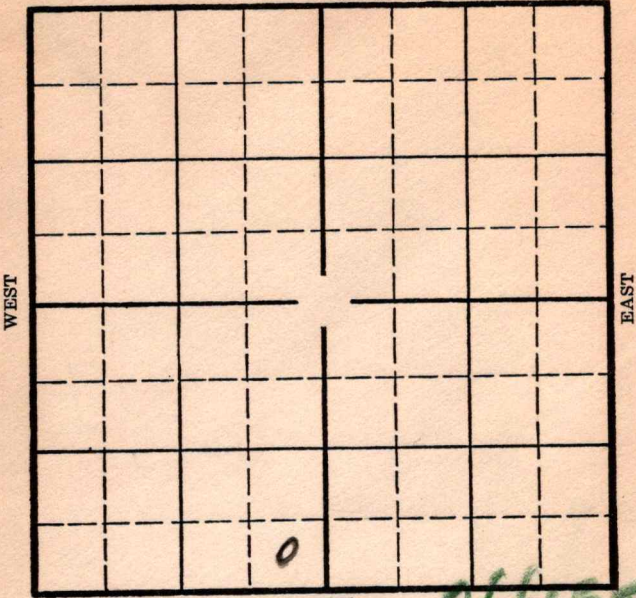

SOUTH

Location _____
 Drilling Remarks _____

Rig Up _____
 Drilling Remarks _____

RECORD

Cased _____ in. _____ ft.
 Sand _____
 Gas _____
 Oil _____
 Total Depth _____

PRODUCTION

1st 24 hrs. Nat. _____
 1st 24 hrs. after shot _____
 Gas _____ cu. ft.
 Dry Hole _____
 Abandoned _____

Well No. 1- M. Gern Farm

Sinclair - Prairie Company

NORTH

Ft. from N. Line

Ft. from S. Line

Ft. from E. Line

Ft. from W. Line

WEST

EAST

SOUTH

REPORT

Elev. 1766

3/11 Rgn

3/20 12" - 170 Drlg. 1375

3/27 Coring 3285'

4/2 T. Sil. 3289' T.D. 3294' 7" - 3289'
Drlg. plug.

4/4 T.D. 3301 1500' oil in hole (Tel)

4/7 T.D. 3301 Swabbing 9 bbls. per hour
after acid (Teleg)

4/8 Acidized with 1000 gallons acid
Opened well and would only swab 9 bbls.
per hour Will now acidize with 5000
gallons acid (Tel)

4/16 3000 acid.

4/23 T.D. 3311' - 428 bbls

4/30 Drlg. 3322'. Water. P.B. 3312'
Testing.

5/7 Pump 115 bbls in 4 hours.

5/13/36 - Sil. 3289'. 7000 acid.
T.D. 3322'. Pump 244 bbls.
P.B. 3311'

COMPLETED

(OVER)

7/1/36--2nd Acidizing--5000 gallons
Waiting (Tel)

Form 26-1M Bks 9-28
Barton

Map No. 46 Sec. 25 Twp. 19 R. 11W

Well No. 1-M. Isern

Sinclair-Prairie Company

Contractor

FIRST REPORTS

SECTION PLAT

Ft. from N. Line

330 Ft. from S. Line

330 Ft. from E. Line

Ft. from W. Line

offset

Location

Rig up

Drilling and Remarks:

Sign

RECORD

Cased _____ in., _____ ft.

Sand _____

Gas _____

Oil _____

Total Depth _____

PRODUCTION

1st 24 hrs. Nat. _____

1st 24 hrs. after shot _____

Gas _____ Cu. Ft.

Dry Hole _____

Abandoned _____

Date


3-11-36 192. _____ Scout

ORVAL MANNSCHRECK

Map No. 46 Sec. 25 Twp. 19 R. 11WWell No. 1 M LscauSinclair - Prairie Company

Contractor

SECTION PLAT

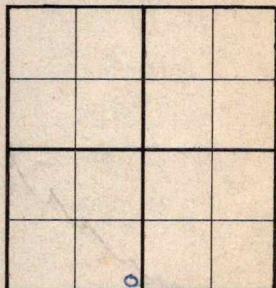

_____ Ft. from N. Line

330 Ft. from S. Line330 Ft. from E. Line

_____ Ft. from W. Line

COMPLETED

Location _____

Rig up _____

Drilling and Remarks:

S. 63289P.B. 33117000 acidPump 244886

RECORD

Cased _____ in., _____ ft.

Sand _____

Gas _____

Oil _____

Total Depth 3322

PRODUCTION

1st 24 hrs. Nat. _____

1st 24 hrs. after shot _____

Gas _____ Cu. Ft.

Dry Hole _____

Abandoned _____

Date

MAY 13 1936

19

S. J. LEWIS

Scout