
Form 51 5M 7-22 9573

Map No. _____ Sec. 13 Twp. 23 R. 10

Well No. 8 Piatt Farm

Empire Company

NORTH

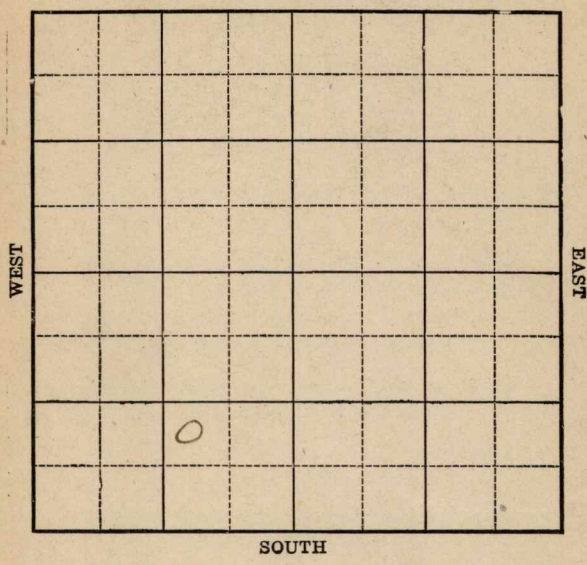

Location _____

Drilling Remarks:

Rig up _____

Drilling Remarks:

RECORD

Cased _____ in. _____ ft.

Sand _____

Gas _____

Oil _____

Total Depth _____

PRODUCTION

1st 24 hrs Nat. _____

1st 24 hrs. after shot _____

Gas _____ cu. ft.

Dry Hole _____

Abandoned _____

Form 252A 8M-11-20 PALACE-TULSA 4617

Map No. Sec. 13 Twp. 23 R. 10

Well No. 8 Pratt Farm

Empire Company


NORTH

Ft. from N. Line

990 Ft. from S. Line

990 Ft. from E. Line

Ft. from W. Line

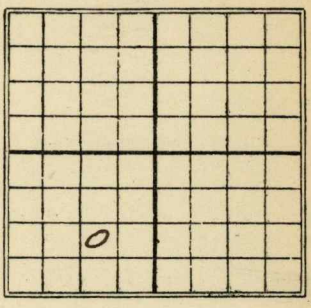

Date	REPORT
1923	
3/22	R.O.D.
6/10	Pay 2028-2100-Shot 140 qts. 120 Bbls. J.W. 2104'

Form 26—1M Bks.—3-23—11959.

Map No. KANSAS 16 Sec. 13 Twp. 23 R. 10

Well No. 3 Piatt

Empire Company

Contractor

FIRST REPORT


Ft. from N. Line

990 Ft. from S. Line

990 Ft. from E. Line

Ft. from W. Line

SECTION PLAT

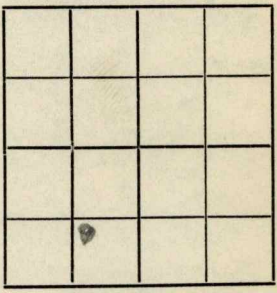

Location

Rig up

Drilling and Remarks:

R. D. S.

RECORD

Cased in., ft.

Sand

Gas

Oil

Total Depth

PRODUCTION

1st 24 hrs. Nat.

1st 24 hrs. after shot

Gas Cu. Ft.

Dry Hole

Abandoned

Date

MAR 22 1923

192

M. A. BENEAR

Scout

Form 26—1M Bks.—3-23—11959.

Map No. KANSAS Sec. 13 Twp. 23 R. 10


Well No. 3 Pratt

Empire Company

Contractor

COMPLETED

SECTION PLAT

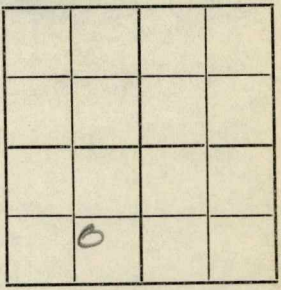

Ft. from N. Line

990 Ft. from S. Line

990 Ft. from E. Line

Ft. from W. Line

Location

Rig up

Drilling and Remarks:

pay {2027-2100

TD. 2104

140/120 bbls.

RECORD

Cased in., ft.

Sand

Gas

Oil

Total Depth

PRODUCTION

1st 24 hrs. Nat.

1st 24 hrs. after shot

Gas Cu. Ft.

Dry Hole

Abandoned

Date

JUN 10 1923

192

M. A. BENEAR

Scout