
Form 51—5M—7-25—19786

Map No. K Sec. 13 Twp. 23 R. 10

Well No. 11 Piatt Farm

Empire G & P. Company

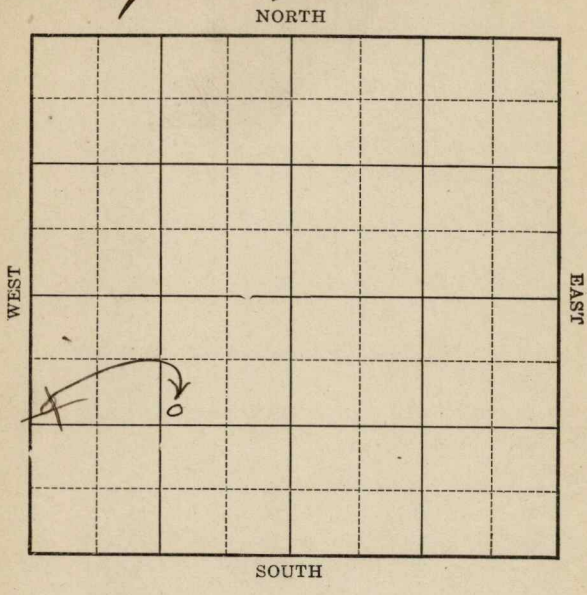

Location

Drilling Remarks

Rig Up

Drilling Remarks

RECORD

Cased in. ft.

Sand

Gas

Oil

Total Depth

PRODUCTION

1st 24 hrs. Nat.

1st 24 hrs. after shot

Gas cu. ft.

Dry Hole

Abandoned

Form 252A—5M—11-25—20913

Greenwood

Map No. Kansas Sec. 13 Twp. 23 R. 10

Well No. 11 Pratt Farm


Empire G. & F. Company

990 Ft. from N. Line

Ft. from S. Line

990 Ft. from E. Line

~~330~~ Ft. from W. Line

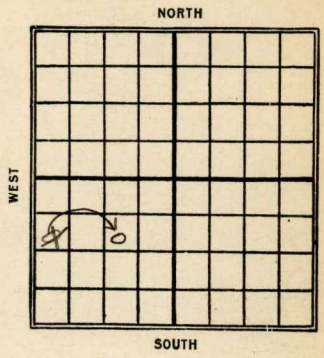

Date	REPORT
1926	
6/2	Rig up
6/10	same
6/18	Dlg 400
6/25	" 1580
6/30	S/D 1580
7/8	Dlg 1670
7/15	top sand 2033-2082' T.D. 2085 - 400' oil in hole, shot 200 qts. C. O.
7/21	Sd. 2033-2082 200/75 bbls. T.D. 2085

Form 26—1M Bks.—3-23—11959. Sherwood

K16 KANSAS

Map No. ---------- Sec. 13 Twp. 23 R. 10

Well No. 11 Platt

Comp Pitt Sup Co ---------- Company

---------- Contractor

FIRST REPORTS


990 ---------- Ft. from N. Line

---------- Ft. from S. Line

---------- Ft. from E. Line

330 ---------- Ft. from W. Line

SECTION PLAT

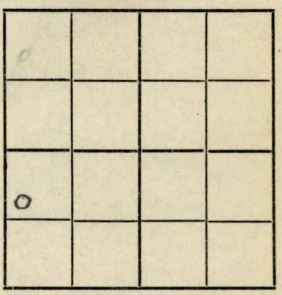

Location ----------

Rig up ✓

Drilling and Remarks:

RECORD

Cased ---------- in., ---------- ft.

Sand ----------

Gas ----------

Oil ----------

Total Depth ----------

PRODUCTION

1st 24 hrs. Nat. ----------

1st 24 hrs. after shot ----------

Gas ---------- Cu. Ft.

Dry Hole ----------

Abandoned ----------

Date

JUN 2 1926

---------- 192---

CHAS. L. SHERWOOD

---------- Scout

Form 26—1M Bks.—3-23—11959. Sherwood

K16 KANSAS

Map No. _____ Sec. 13 Twp. 23 R. 10

Well No. 11 Platt

Empire Gas & Fuel Co. Company

_____ Contractor

CORRECTION


990 Ft. from N. Line

_____ Ft. from S. Line

990 Ft. from E. Line

_____ Ft. from W. Line

SECTION PLAT

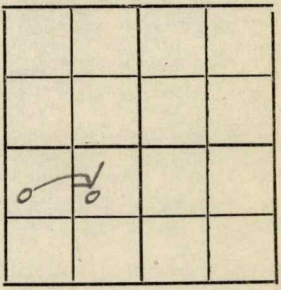

Location _____

Rig up _____

Drilling and Remarks:

Ky 400'
chg location to
above

RECORD

Cased _____ in., _____ ft.

Sand _____

Gas _____

Oil _____

Total Depth _____

PRODUCTION

1st 24 hrs. Nat. _____

1st 24 hrs. after shot _____

Gas _____ Cu. Ft.

Dry Hole _____

Abandoned _____

Date

JUN 18 1926

_____ 192___.

CHAS. L. SHERWOOD

_____ Scout

Form 26—1M Bks.—3-23—11959. Greenwood

Map No. KANSAS Sec. 13 Twp. 23 R. 10

Well No. 11 Platt

Empire Gas & Fuel Co Company

Contractor

COMPLETED


990 Ft. from N. Line

Ft. from S. Line

990 Ft. from E. Line

Ft. from W. Line

SECTION PLAT

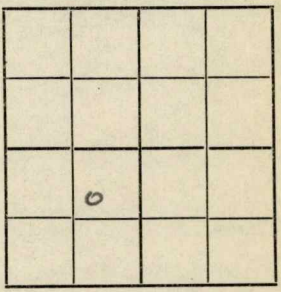

Location

Rig up

Drilling and Remarks:

300/75 lbs.

RECORD

Cased in., ft.

Sand 2032-2082'

Gas

Oil

Total Depth 2085

PRODUCTION

1st 24 hrs. Nat.

1st 24 hrs. after shot

Gas Cu. Ft.

Dry Hole

Abandoned

Date

JUL 21 1926

192

CHAS. L. SHERWOOD

Scout