


Map No. Kansas Sec. 9 Twp. 23 R. 13


Sara Etal Company

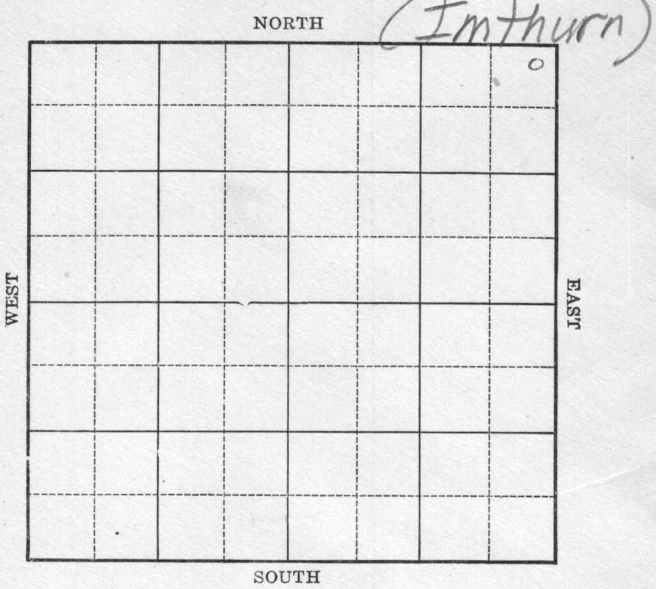

Location _____

Drilling Remarks _____

RECORD

Cased _____ in. _____ ft.
Sand _____
Gas _____
Oil _____
Total Depth _____

Rig Up _____

Drilling Remarks _____

PRODUCTION

1st 24 hrs. Nat. _____
1st 24 hrs. after shot _____
Gas _____ cu. ft.
Dry Hole _____
Abandoned _____


Well No. 3 Smithurn Farm
Gore et al Company

200 Ft. from N. Line

-----Ft. from S. Line

200 Ft. from E. Line

Ft. from W. Line

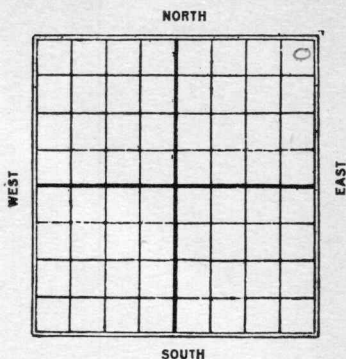[illegible]

K17
 Map No. **KANSAS** Sec. *9* Twp. *23* R. *13*
206 et al

Company

Contractor

COMPLETED

SECTION PLAT

200 Ft. from N. Line

_____ Ft. from S. Line

200 Ft. from E. Line

_____ Ft. from W. Line

			o

Location _____

Rig up _____

Drilling and Remarks:

120/65 Bl.

RECORD

Cased _____ in., _____ ft.

Sand *1542-1592*

Gas _____

Oil _____

Total Depth *1592'*

PRODUCTION

1st 24 hrs. Nat. _____

1st 24 hrs. after shot _____

Gas _____ Cu. Ft.

Dry Hole _____

Abandoned _____

Date

APR 28 1926

192

CHAS. L. SHERWOOD

Scout

Steenwood
K17 KANSAS
 Map No. *5* Sec. *9* Twp. *22* R. *13*
 Well No. *2016* *at 18*
 _____ Company
 _____ Contractor

FIRST REPORTS

200 _____ Ft. from N. Line

_____ Ft. from S. Line

200 _____ Ft. from E. Line

_____ Ft. from W. Line

SECTION PLAT

			0

Location _____

Rig up _____

Drilling and Remarks:

Only 400'

RECORD

Cased _____ in., _____ ft.

Sand _____

Gas _____

Oil _____

Total Depth _____

PRODUCTION

1st 24 hrs. Nat. _____

1st 24 hrs. after shot _____

Gas _____ Cu. Ft.

Dry Hole _____

Abandoned _____

Date

MAR 18 1926

CHAS. L. SHERWOOD

192

Scout