


Map No. Kans. Sec. 9 Twp. 23 R. 13
 Well No. 6 - Smthurn Farm
Yare & Co. Company

NORTH

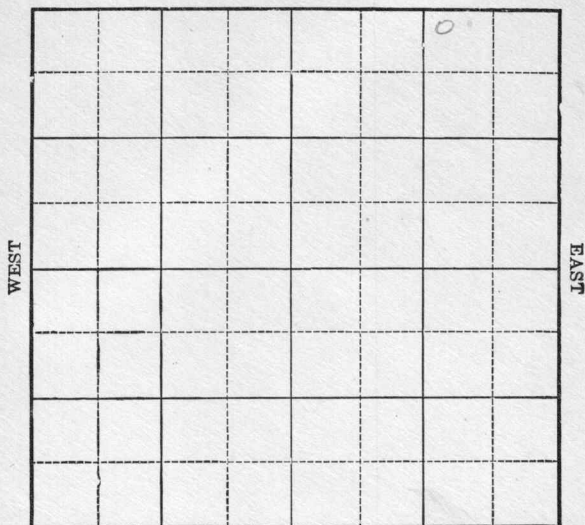

SOUTH

Location _____

Drilling Remarks

Rig Up _____

Drilling Remarks

RECORD

Cased _____ in. _____ ft.

Sand _____

Gas _____

Oil _____

Total Depth _____

PRODUCTION

1st 24 hrs. Nat. _____

1st 24 hrs. after shot _____

Gas _____ cu. ft.

Dry Hole _____

Abandoned _____

Map No. Kansas Sec. 9 Twp. 23 R. 13


Well No. 6-Smithum Farm
Gare Etal Company

250 Ft. from N. Line

_____ Ft. from S. Line

760 Ft. from E. Line

_____ Ft. from W. Line

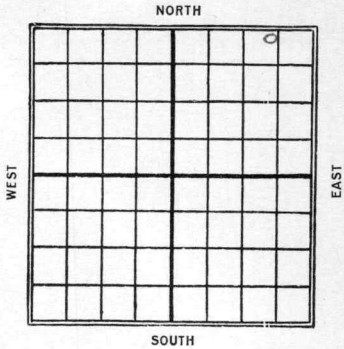

1926

Date

REPORT

4/27 Spudding

5/8 Dlg 715'

5/12 " 1550'

5/19 Sand. 1561-1608 J.D.
120/30 B136.

K-17 *Folsomwood*
 Map No. **KANSAS** Sec. *9* Twp. *23* R. *13*
 Well No. *6* *In thurn*
806 et al

Company

Contractor

COMPLETED

SECTION PLAT

			0

250 Ft. from N. Line

Ft. from S. Line

760 Ft. from E. Line

Ft. from W. Line

Location

Rig up

Drilling and Remarks:

120 30 Bl

RECORD

Cased *1561-1608* in., ft.

Sand

Gas

Oil

Total Depth *1608*

PRODUCTION

1st 24 hrs. Nat.

1st 24 hrs. after shot

Gas Cu. Ft.

Dry Hole

Abandoned

Date

MAY 19 1926

192

CHAS. L. SHERWOOD

Scout

1517 KANSAS Sec. 9 Twp. 23 R. 13
 Map No. 6 Int'l. hurn
 Well No. 8016 et al

Company

Contractor

SECTION PLAT

			o

250 Ft. from N. Line

Ft. from S. Line

760 Ft. from E. Line

Ft. from W. Line

FIRST REPORTS

Location

Rig up

Drilling and Remarks:

Spudding

RECORD

Cased _____ in., _____ ft.

Sand _____

Gas _____

Oil _____

Total Depth _____

PRODUCTION

1st 24 hrs. Nat. _____

1st 24 hrs. after shot _____

Gas _____ Cu. Ft.

Dry Hole _____

Abandoned _____

Date

APR 28 1926

CHAS. L. SHERWOOD

192

Scout