


Section 13 Township 29 Range 1WWell No. #1 Emma RoyCompany Newman Bros.
Shawver & Armour.

NORTH

WEST

EAST

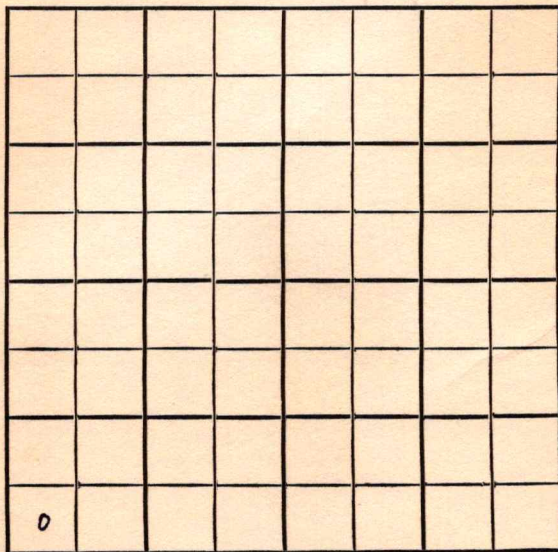

SOUTH

Sedgwick

KANSAS

SEC.	TWP.	R.
13	29	1 W

WELL NO.

1 Emma Roy

FARM

COMPANY

Shawver & Armour

CONTRACTOR

Co. tools

Wildcat

Ft. from N. Line

330

Ft. from S. Line


Ft. from E. Line

330

Ft. from W. Line

SW SW SW

Liom - BHP

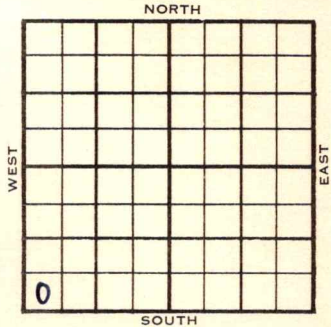

1955

ELEVATION

1282'

REPORT

3/9

Stal. 2430' KC 2744'

3/23

Spud 3-7-55, D&A, TD 3770
 8" @ 288 Stal 2430, KC 2769
 DST 2868-80, open 1 hr Rec 5'
 ocm 1000#, Miss 3337, DST 3337-
 80 open 1 hr Rec 90' SOCM
 210' MSW TD 3770
 D&A

ABANDONED

Sec. **13** (Blk. **29** (Sur. **1W** Map No.

Well No. 1 Farm Emma Roy

Elev.	Location	SW SW SW
-------	----------	-----------------

0

FIRST REPORT

330 Ft. From S Line SW

330 Ft. From W Line Quarter

1st. Report MAR 9 1955

Completion

Remarks **Lion - BHP**

Co. tools

Spudding Date _____

Drlg. Data Wildcat

Stal. 2430 KC 2744

FABEN GILSTRAP

FABEN GILSTRAP

O.W.W.O.

FORM 513 SUNRAY

County Sedgwick Elev. _____
 Sec. 13 Twp. 29 Rge. 1W
 Company Newman Bros.
 Farm Name Emma Ray No. 1

TOPS	DEPTH	LOG	DATUM	Loc. in Sec.
Anh.				SW SW SW
TP.				
H.				
Tr. <u>Stal.</u>	<u>2440</u>			<u>O.W.O.</u>
Dg.				
Bl.				
L.				Geol. _____
K.C.	<u>2772</u>			Contr. _____
B.K.C.	<u>2978</u>			<u>F. Raymond</u>
Ce.				Pool _____
C.				
M.				
M.	<u>3337</u>			
K.				
Mz.				
Mq.				
V.				
S.				
S.	<u>3740</u>			
A.				
R.				
PE.				
G.				
T.D.	<u>3770</u>			

Date Comm. OTD 3770
 DST 2878-90 open 45 min. rec. 5' socm
 1000# DST 3341-80 open 1 hr.
 rec. 600' gas 90' so & gcm
 210' muddy sw 1250#
 New infor - Washed hole down and set
 pipe

28

County Sedgwick Elev. _____
 Sec. 13 Twp. 29 Rge. 1W
 Company Newman Bros.
 Farm Name Emma Ray No. 1

TOPS	DEPTH	LOG	DATUM	Loc. in Sec.
Anh.				SW SW SW
Tr.	<u>Stal.</u>	<u>2440</u>		OWEO
Dg.				
Bl.				
L.				
K.C.	<u>2772</u>			Geol.
B.K.C.	<u>2978</u>			Contr.
Ce.				F. Raymond
C.				Pool
M.	<u>3337</u>			
M.				
K.				
Mz.				
Me.				
V.				
S.				
S.	<u>3740</u>			
A.				
R.				
Pe.				
G.				
T.D.	<u>3770</u>			

MAY 1 '57

COMPLETE

Date Comm. call Pat Raymond.DST 2878-90 open 45 min. rec. 5' socn1000# DST 3341-80 open 1 hr.rec. 600' gas 90' so & gcm210' muddy sw 1250#New infor - Washed hole down and setpipe Nov 20 '56 Tite hole Pipe setDEC 5 '56 DEC 12 '56 DEC 19 '56 DEC 26 '56JAN 2 '57JAN 9 '57PF 3368-723360-67 + ST 4 Bwph

60 gal acid test 14 BFph
+SSO PF 3350-56 1 1/2 no
+ST PF 3360-63 100 acid
+ST 5 GFph (50% oil) 1/2
+ST 12 BFph +SSO FU
2850' Fluid (50% oil) 50d
All PF'S PF 3350-56 1 1/4
\$ 6 BFph (50% oil)

JAN 15 1977

ERN 23-47 ✓

JAN 20 '57 (Pat Raymond)

T&R FEB 6 57 FEB 13 57 X w.o. pump
unit FEB 20 57 X POP FEB 27 57 X MAR 6 57

MAR 13 '57 MAR 20 '57 MAR 27 '57 APR 3 '57 APR 10 '57

APR 17 '57 APR 24 '57 MAY 1 '57 0 1 B.

APR 17 '57 APR 24 '57 MAY 1 '57 P. 6 Bopd
+ 110 Bwpd S.D. wo
SWD well

77. *St. Marks* Salt Lake

13-29-jw

and that