

Map No. **KANSAS** Sec. 22 Twp. 2 R. 2Well No. 1-62 Camel Farm 2

Company

NORTH

WEST

EAST

SOUTH

0

Location

Drilling Remarks

Rig Up

Drilling Remarks

RECORD

Cased _____ in. _____ ft.

Sand

Gas

Oil

Total Depth

PRODUCTION

1st 24 hrs. Nat.-----

1st 24 hrs. after shot -----


Gas _____ cu. ft. _____

Dry Hole

Abandoned.....

Sedgwick
 Map No. **KANSAS** Sec. *30* Twp. *27* R. *2^E*
 Well No. *1- Rimel* Farm
Derby Oil Company

330 Ft. from N. Line
 _____ Ft. from S. Line
990 Ft. from E. Line
 _____ Ft. from W. Line
1930

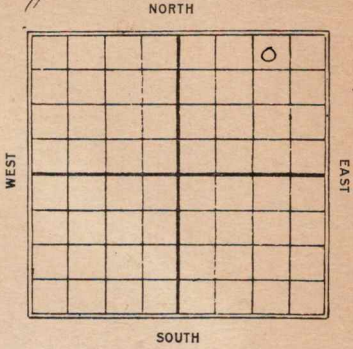

Date REPORT

<i>7/23</i>	<i>ROG</i>
<i>7/30</i>	<i>Sur. pipe 56'</i>
<i>8/6</i>	<i>hrlg. 1215'</i>
<i>8/13</i>	<i>" 2250'</i>
<i>8/20</i>	<i>Top Chat 2950-62</i>
	<i>Testing</i>
<i>8/21</i>	<i>Base Line 3188'</i>
	<i>8" - 3235' Rust</i>
<i>9/3</i>	<i>Top Wilcox 3233-36</i>
	<i>swab 1565 bbls</i>
<i>1931</i>	OWDD
<i>4/8</i>	<i>Old T.D. 3236</i>
	<i>Top Viola 3248</i>
	<i>HFW 3254</i>
	<i>drly 3370'</i>
<i>4/15</i>	<i>Log 3379</i>
<i>4/22</i>	<i>— 6/3 — 7/15 —</i>
<i>4/29</i>	<i>— 6/10 — (over)</i>
<i>5/6</i>	<i>— 6/17 —</i>
<i>5/13</i>	<i>— 6/24 —</i>
<i>5/20</i>	<i>— 7/1 —</i>
<i>5/27</i>	<i>— 7/8 —</i>

7/22- ⁷⁵⁶³¹³ set 5"-3376
T.D. 3379 Cfy out

7/29- T.D. 3379
P.B. to 3250

Sand 3231-33
swab 7 bbl oil and
12 bbl water per hr

8/5- T.D. 3379
P.B. to 3250

Sand 3231-33

Made 160 bbl oil
and 160 " water
Comp.

Sealgebeck 12
 Map No. **KANSAS** Sec. 30 Twp. 27 R. 2E

Well No. 1 Rincel

Terry Oil Company

Contractor

SECTION PLAT

			0

380 Ft. from N. Line

_____ Ft. from S. Line

990 Ft. from E. Line

_____ Ft. from W. Line

FIRST REPORTS

Location _____

Rig up _____

Drilling and Remarks:

ROG

RECORD

Cased _____ in., _____ ft.

Sand _____

Gas _____

Oil _____

Total Depth _____

PRODUCTION

1st 24 hrs. Nat. _____

1st 24 hrs. after shot _____

Gas _____ Cu. Ft.

Dry Hole _____

Abandoned _____

Date

JUL 23 1930

19

S. J. LEWIS

Scout

Map No. **KANSAS** Sec. 30 Twp. 27 R. 25

Well No. 1 Rinel

Derby Oil Company

Contractor

SECTION PLAT

			0

330 Ft. from N. Line

_____ Ft. from S. Line

990 Ft. from E. Line

_____ Ft. from W. Line

COMPLETED

Location _____

Rig up _____

Drilling and Remarks:

Wilcox 3 233-86

swath 1565886

RECORD

Cased _____ in., _____ ft.

Sand _____

Gas _____

Oil _____

Total Depth 8236

PRODUCTION

1st 24 hrs. Nat. _____

1st 24 hrs. after shot _____

Gas _____ Cu. Ft.

Dry Hole _____

Abandoned _____

Date

SEP 3 1930

S. J. LEWIS

Scout

12 **KANSAS** Sec. 30 Twp. 27 R. 2 ^E

Well No. 1 Rimel
Derby Oil Co. Company

Contractor

FIRST REPORTS

330 Ft. from N. Line

Ft. from S. Line

990 Ft. from E. Line

Ft. from W. Line

"old well deeper"

SECTION PLAT

			0

Location

Rig up 2D was 3236'

Drilling and Remarks:

Top Viola 3248'

HFV 3254'

Big 3370'

RECORD

Cased in., ft.

Sand

Gas

Oil

Total Depth

PRODUCTION

1st 24 hrs. Nat.

1st 24 hrs. after shot

Gas Cu. Ft.

Dry Hole

Abandoned

Date

APR 8 1931

192

CHAS. L. SHERWOOD

Scout

Shagwino

12 KANSAS

Map No. Sec. 30 Twp. 27 R. 2 E

Well No. 1 Primer

Derby Oil Co. Company

Contractor

SECTION PLAT

COMPLETE

330 Ft. from N. Line

Ft. from S. Line

990 Ft. from E. Line

Ft. from W. Line

			0

Location

Rig up

Drilling and Remarks:

PB to 3250

160 lbs oil

160 " water.

RECORD

Cased in, ft.

Sand 3231-3233

Gas

Oil

Total Depth 3379

PRODUCTION

1st 24 hrs. Nat.

1st 24 hrs. after shot

Gas Cu. Ft.

Dry Hole

Abandoned

Date

AUG 5 1931

CHAS. L. SHERWOOD

192

Scout