


Ellis

KANSAS

SECTION 27 TOWNSHIP 11S RANGE 16W

WELL NO. #1 Snapp

COMPANY Rupp-Ferguson

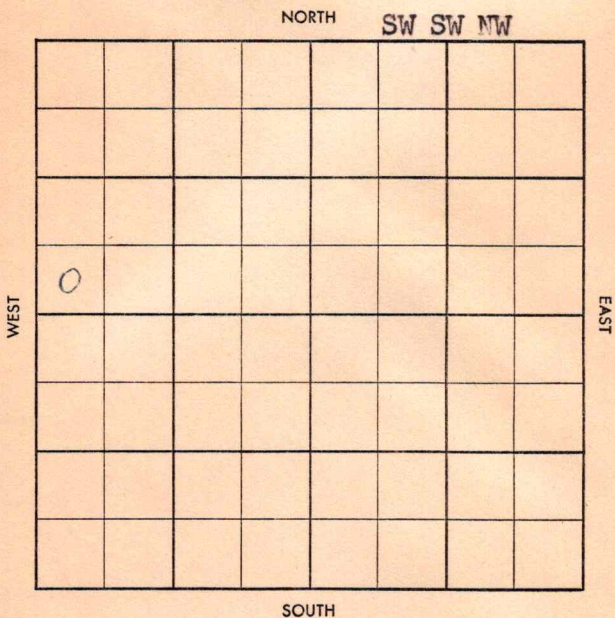

Twp. ~~X~~ Pool ~~T~~
 Co. ~~X~~ Facet ~~X~~

WILDCAT

S-513-B

County Ellis Elev. 1776 DF
 Sec. 27 Twp. 11 Rge. 16W
 Company Rupp-Ferguson
 Farm Name Snapp No. 1

TOPS	DEPTH	LOG	DATUM
Anh.			
Tp.			
H.			
Tr.			
Dg.			
B.L.			
L.			
K.C.			
B.K.C.			
Ce.			
C.			
M.			
M.			
K.			
Mz.			
Mq.			
V.			
S.			
S.			
A.			
R.			
Pf.			
G.			
T.D.			

Loc. in Sec. SW SW NW
 Geol. Singleton
 Contr. _____
Prime Drlg.
 Pool _____
Wildcat



Date Comm. 6-5-58
8" @ 940 Drlg. 2490

Co.
Lse.
No.
Sec.
T.
R.

Twp. No Post No
 Co. No Foot No

S-513-B

County Ellis Elev. 1776 DF 1779
 Sec. 27 Twp. 11 Rge. 16W
 Company Rupp-Ferguson
 Farm Name Snapp No. 1

TOPS	DEPTH	LOG	DATUM
Anh.			
Tp.			
H.		<u>2936</u>	
Tr.		<u>2958</u>	
Dg.			
B.L.			
L.		<u>2985</u>	
K.C.			
B.K.C.			
Ce.			
C.			
M.			
M.			
K.			
Mz.			
Mq.			
V.			
S.			
A.		<u>3318</u>	
R.			
Pf.			
G.			
T.D.	<u>3338</u>		

Loc. in Sec. SW SW NW
 Geol. Singleton
 Contr. Prime Drlg.
 Pool CHRISTAL
501
Wildcat

COMPLETE
 AUG 13 '58

Date Comm. 6-5-58
8" @ 940 Drlg. 2490 JUN 18 '58 DST 3014-54
1 hr 1' free oil 68' MCO 1' W BHP
1100/20" DST 3077-3165 1 hr 120'
H gem 700' g & mco 370' g & ocm
BHP 1180-1020/20" FP 220-440
DST 3317-20 1 hr 5' so spk M BHP
900/20" DST 3317-25 @ 15" BHP 4' M
BHP 1120-1060/20" DST 3317-38 @
1 hr 2360' SW FP 860-1120 BHP 1100
-1120 5 1/2" 3338 JUN 25 '58 JUL 2 '58

JUL 9 '58 12/3158-61 20/3148-53
 32/3139-46 2500A \$ 3080
 phNW ~~9~~ 2hrs PB 3100 20/
 3080-85 \$ 1080 phNW net
 2500A CO 3100 PB 3050
 20/3013-18 2500A \$40 BOPh NW
 CO 3850 \$ all zones \$ 3230
 phNW 4hrs 1900' OB 36-38°
 JUL 16 '58 JUL 23 '58 P 65 BOPd NWWD
 JUL 30 '58 AUG 6 '58 AUG 13 '58 phyP 296
 P BOPd + trw gr 37°
 Lsg 3013 - 3161
 TD 3338

27-11-16 W

SW SW NW