

Map No. _____ Sec. 16 Twp. 25 R. 17

Well No. 1 Flowing Farm

Frank Young & Co. Company


NORTH

Ft. from N. Line

200 Ft. from S. Line

200 Ft. from E. Line

Ft. from W. Line

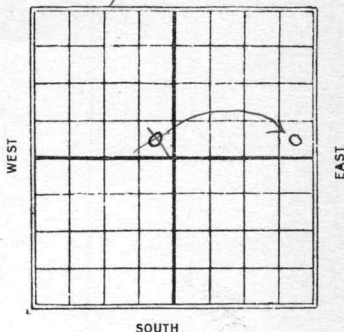

1929

Date _____

REPORT

10/30

REPORT

Location

11/6

Wrlg 825'

11/1.3

Top line, 1595'

T.D. 1625' HFW
dry & abandon

try & Abandon

Copper

17 KANSAS
 Map No. _____ Sec. 11 Twp. 23 R. 14^E
 Well No. 1 *Levering*
Frans, Young et al Company
 _____ Contractor

FIRST REPORTS

_____ Ft. from N. Line
700 Ft. from S. Line
700 Ft. from E. Line
 _____ Ft. from W. Line

SECTION PLAT

Location *✓*

Rig up _____

Drilling and Remarks:

RECORD

Cased _____ in., _____ ft.

Sand _____

Gas _____

Oil _____

Total Depth _____

PRODUCTION

1st 24 hrs. Nat. _____

1st 24 hrs. after shot _____

Gas _____ Cu. Ft.

Dry Hole _____

Abandoned _____

Date

CHAS. L. SHERWOOD


OCT 30 1929 192 _____ Scout

Copper
17 **KANSAS** Sec. *11* Twp. *73* R. *14*^E
Well No. *1* *Revering*
Francis Gering & Co Company
Contractor

CORRECTION

.....Ft. from N. Line
700 Ft. from S. Line
700 Ft. from E. Line
.....Ft. from W. Line

SECTION PLAT

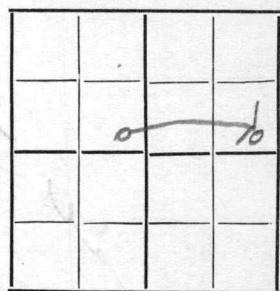

Location.....
Rig up *875'*
Drilling and Remarks:

Chy location.

RECORD

Cased.....in.,ft.
Sand.....
Gas.....
Oil.....
Total Depth.....

PRODUCTION

1st 24 hrs. Nat.....
1st 24 hrs. after shot.....
Gas.....Cu. Ft.
Dry Hole.....
Abandoned.....

Date

NOV 6 1929

CHAS. L. SHERWOOD

192.....Scout

Map No. KANSAS Sec. 11 Twp. 23 R. 14

Well No. 1 Levering

Frank Young & Co. Company

Contractor

COMPLETE

SECTION PLAT

.....Ft. from N. Line

700 Ft. from S. Line

700 Ft. from E. Line

.....Ft. from W. Line

			0

ABANDONED

Location.....

Rig up.....

Drilling and Remarks:

Log line 1595

RECORD

Cased.....in.,ft.

Sand.....

Gas.....

Oil.....

Total Depth 1675 ft.

PRODUCTION

1st 24 hrs. Nat.....

1st 24 hrs. after shot.....

Gas.....Cu. Ft.

Dry Hole ☒

Abandoned ☒

Date

NOV 13 1929

192

CHAS. L. SHERWOOD

Scout