

KANSAS

Ellis


Form 51-5M-7-39-Palace

Section 6 Township 11 Range 17-W

Well No. ~~#3~~ Henderson "B" #4

Company Dickey Oil

Burnett South Pool
NORTH

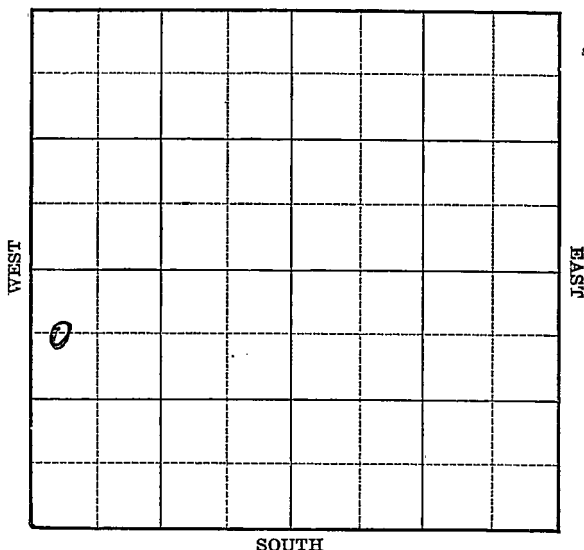

12

1940
7/10

Arb. 3562 $\frac{1}{2}$ '

7" - 3562 $\frac{1}{2}$ '

T.D. 3570'

1500 acid.

Echometer potential 2193 bbls.

COMPLETED

Map No. 71 Sec. 6 Twp. 11 R. 17W

Well No. 3 Henderson "B"

Dickey Oil Company

Contractor

FIRST REPORT

C $W\frac{1}{2}$ NW SW

SECTION PLAT

660 Ft. from N. Line

_____ Ft. from S. Line

_____ Ft. from E. Line

330 Ft. from W. Line

BURNETT SOUTH POOL

Location X

Rig up _____

Drilling and Remarks:

RECORD

Cased _____ in., _____ ft.

Sand _____

Gas _____

Oil _____

Total Depth _____

PRODUCTION

1st 24 hrs. Nat. _____

1st 24 hrs. after shot _____

Gas _____ Cu. Ft.

Dry Hole _____

Abandoned _____

Date

MAY 1 1940 19

S. J. LEWIS Scout

Ellis KANSAS

Map No. 7/ Sec. 6 Twp. 11 R. 17WWell No. 4 Henderson "B"Dickey Oil CompanyCORRECTION Contractor

SECTION PLAT

C W L NW SW

660 Ft. from N. Line

_____ Ft. from S. Line

_____ Ft. from E. Line

330 Ft. from W. Line

Burnett South Pool

o			

Location _____

Rig up _____

Drilling and Remarks:

Reported as #3

RECORD

Cased _____ in., _____ ft.

Sand _____

Gas _____

Oil _____

Total Depth _____

PRODUCTION

1st 24 hrs. Nat. _____

1st 24 hrs. after shot _____

Gas _____ Cu. Ft.

Dry Hole _____

Abandoned _____

Date

MAY 9 1940 19S. J. LEWIS Scout

Map No. _____ Sec. 6 Twp. 11 R. 17W

Well No. 4 Henderson "B"

Dickey Oil Company

Contractor

COMPLETED

C $W\frac{1}{2}$ NW SW

660 Ft. from N. Line

_____ Ft. from S. Line

_____ Ft. from E. Line

330 Ft. from W. Line

BURNETT SOUTH POOL

SECTION PLAT

o			

Location _____

Rig up _____

Drilling and Remarks:

cell 3562 1/2

7" @ 3562 1/2

1500 acid

Ec log meter

2193

RECORD

Cased _____ in., _____ ft.

Sand _____

Gas _____

Oil _____

Total Depth 3570

PRODUCTION

1st 24 hrs. Nat. _____

1st 24 hrs. after shot _____

Gas _____ Cu. Ft.

Dry Hole _____

Abandoned _____

Date

JUL 10 1940 19

S. J. LEWIS Scout