
Form 51—5M—10-26—Mid-West

Greenwood

Map No. Ks Sec. 19 Twp. 23 R. 10

Well No. 2 Race Farm

Both Fairrot & Manhattan Company

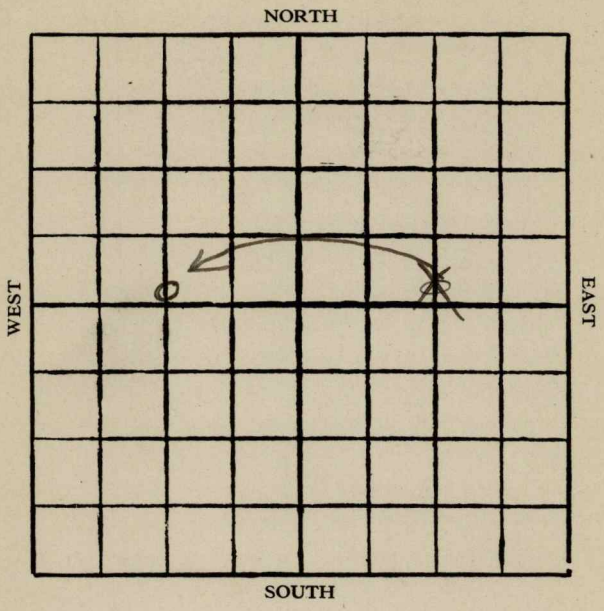


Location	Rig Up
Drilling Remarks	Drilling Remarks
RECORD	PRODUCTION
Cased ..... in. ..... ft.	1st 24 hrs. Nat.
Sand	1st 24 hrs. after shot
Gas	Gas ..... cu. ft.
Oil	Dry Hole
Total Depth	Abandoned

Form 252A—5M—11-25—20913 Greenwood

Map No. Kan Sec. 19 Twp. 23 R. 10

Well No. 2 - Race Farm

Roth-Faurot-Manhattan Company

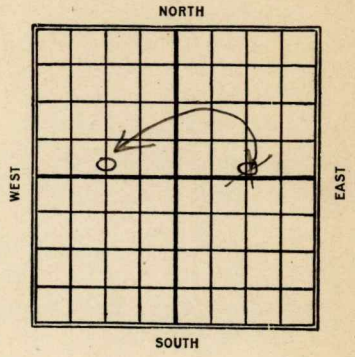

____ Ft. from N. Line

200 Ft. from S. Line

~~1320~~ Ft. from E. Line

~~1320~~ Ft. from W. Line

1926

Date	REPORT
11/11	Timbers
11/17	Same
11/23	Bldg Rig
12/8	rig
12/15	—
12/22	—
12/30	Rigging up
1927	
1/6	Same
1/13	Drlg 500
1/19	" 1210
1/26	" 1695
2/3	" 1900
2/10	Dry sand 2290-97
	D. & A. 2325'

Form 26—1M Bks.—3-23—11959. Sherwood

16 KANSAS


Map No._____ Sec. 19 Twp. 23 R. 10

Well No. 2 Race

Both-Faurot & Manhattan Company

_____ Contractor

SECTION PLAT

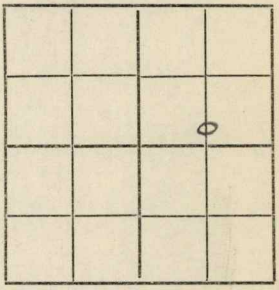

_____ Ft. from N. Line

200 Ft. from S. Line

1320 Ft. from E. Line

_____ Ft. from W. Line

FIRST REPORTS

Location _____

Rig up timbers

Drilling and Remarks:

RECORD

Cased _____ in., _____ ft.

Sand _____

Gas _____

Oil _____

Total Depth _____

PRODUCTION

1st 24 hrs. Nat. _____

1st 24 hrs. after shot _____

Gas _____ Cu. Ft.

Dry Hole _____

Abandoned _____

Date

NOV 11 1926

CHAS. L. SHERWOOD

_____ 192____. _____ Scout

Form 26—1M Bks.—3-23—11959. Glenwood

16 KANSAS

Map No.---------- Sec. 19 Twp. 23 R. 10


Well No. 2 Lacy

Roth-Faurot & Manhattan Company

---------- Contractor

CORRECTION

SECTION PLAT

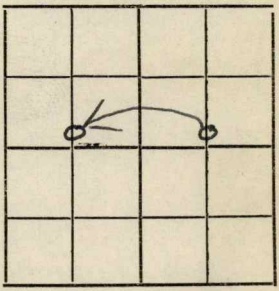

---------Ft. from N. Line

700 Ft. from S. Line

---------Ft. from E. Line

1320 Ft. from W. Line

Location ----------

Rig up ----------

Drilling and Remarks:

Rigged up

chg location

RECORD

Cased---------in., ------- ft.

Sand ----------

Gas ----------

Oil----------

Total Depth----------

PRODUCTION

1st 24 hrs. Nat. ----------

1st 24 hrs. after shot-------

Gas----------Cu. Ft.

Dry Hole----------

Abandoned----------

Date

JAN 6 1927

CHAS. L. SHERWOOD

----------192---. ----------Scout

Form 26—1M Bks.—3-23—11959. Sherwood

16 KANSAS

Map No. ---------- Sec. 19 Twp. 23 R. 10


Well No. 2 Rock

Roth-Faurot & Manhattan Company

---------- Contractor

COMPLETED

SECTION PLAT

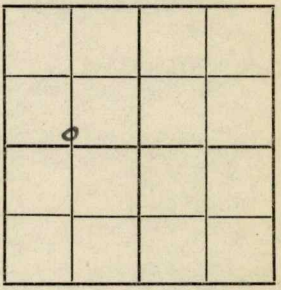

---------Ft. from N. Line

200 Ft. from S. Line

---------Ft. from E. Line

1320 Ft. from W. Line

ABANDONED

Location ----------

Rig up ----------

Drilling and Remarks:

Shy Sand 2290-97

D&G 2325

RECORD

Cased ---------in., ------- ft.

Sand ----------

Gas ----------

Oil ----------

Total Depth 2325

PRODUCTION

1st 24 hrs. Nat. ----------

1st 24 hrs. after shot ------

Gas ----------Cu. Ft.

Dry Hole ✓

Abandoned ----------

Date

FEB 10 1937

---------- 192---- CHAS. L. SHERWOOD

---------- Scout