
Form 51—5M—7-25-19786

Greenwood Co

Map No. Kansas Sec. 19 Twp. 23 R. 9

Well No. 2 Morris Farm

Empire G. & F. Company

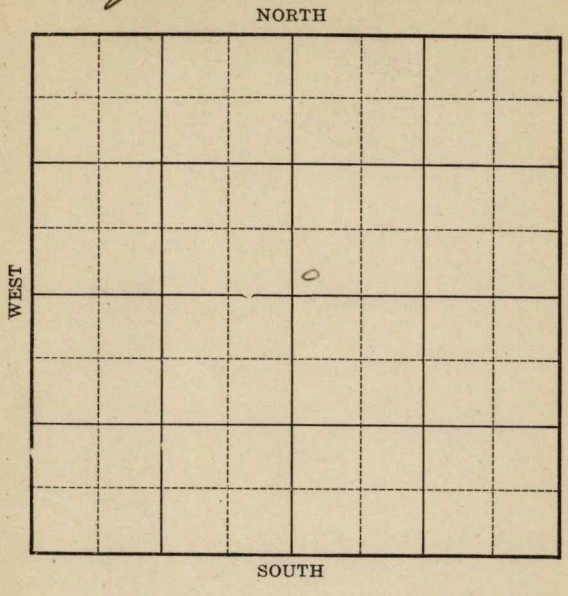

Location

Drilling Remarks

Rig Up

Drilling Remarks

RECORD

Cased in. ft.

Sand

Gas

Oil

Total Depth

PRODUCTION

1st 24 hrs. Nat.

1st 24 hrs. after shot

Gas cu. ft.

Dry Hole


Abandoned

Form 252A—5M—7-25—19684 Greenwood Co

Map No. Kansas Sec. 19 Twp. 23 R 9

Well No. 2 Morris Farm

Empire G. + F Company

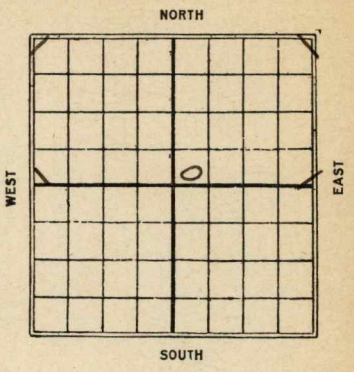

_____ Ft. from N. Line

330 Ft. from S. Line

_____ Ft. from E. Line

330 Ft. from W. Line

Date	REPORT
1925	
12/17	Location
12/23	Bldg rig
12/31	
1926	
1/8	Rigging up.
1/14	Drlg 230'
1/20	" 740'
1/21	" 1445'
2/4	" 2200'
2/10	" 2300'
2/17	Top sand 2540-95' plugged back to 2572' 1000 Oil in hole Will shoot.
2/24	Sand 2540-2595 50 gt 80 Oil 15 Water

Form 26—1M Bks.—3-23—11959. Glenwood Co


Map No. KANSAS Sec. 15 19 Twp. 22 R. 9

Well No. 2 No Ellis

Empire Gas & Fuel Company

Contractor

SECTION PLAT

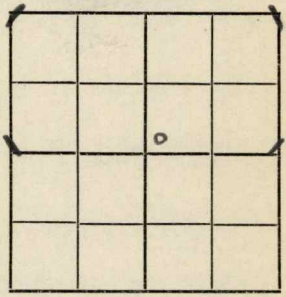

330 Ft. from N. Line

330 Ft. from S. Line

Ft. from E. Line

Ft. from W. Line

FIRST REPORTS

Location ✓

Rig up

Drilling and Remarks:

RECORD

Cased in., ft.

Sand

Gas

Oil

Total Depth

PRODUCTION

1st 24 hrs. Nat.

1st 24 hrs. after shot

Gas Cu. Ft.

Dry Hole

Abandoned

Date

DEC 17 1925

192

CHAS. L. SHERWOOD

Scout

Form 26—1M Bks.—3-23—11959. Sherwood C.

1215 KANSAS

Map No. _____ Sec. 19 Twp. 23 R. 9

Well No. 2 Morris

Empire Gas & F Co. Company

_____ Contractor

COMPLETED


_____ Ft. from N. Line

330 Ft. from S. Line

_____ Ft. from E. Line

330 Ft. from W. Line

SECTION PLAT

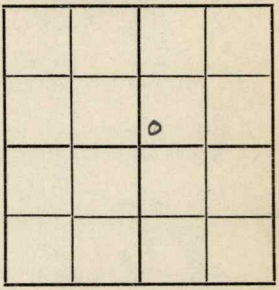

Location _____

Rig up _____

Drilling and Remarks:

Plugged Back to 2572'

50 bbls oil

80 bbls Water

15 bbls

RECORD

Cased _____ in., _____ ft.

Sand 2540-2595

Gas _____

Oil _____

Total Depth 2595

PRODUCTION

1st 24 hrs. Nat. _____

1st 24 hrs. after shot. _____

Gas _____ Cu. Ft.

Dry Hole _____

Abandoned _____

Date

FEB 24 1926

192____

CHAS. L. SHERWOOD

_____ Scout