

KANSAS

Butler

Section 20 Township 29 Range 8E

Well No. 1 Hoard

Company K. T. Weidemann

Misc.

NORTH

WEST

EAST

o							

SOUTH

KANSAS Butler
29

8E

Sec. 20 Twp. R.

Well No. #1 Hoard Farm

K.T. Weidemann
Misc.

Company

Ft. from N. Line

990


Ft. from S. Line

Ft. from E. Line

330

Ft. from W. Line

NW SW NW

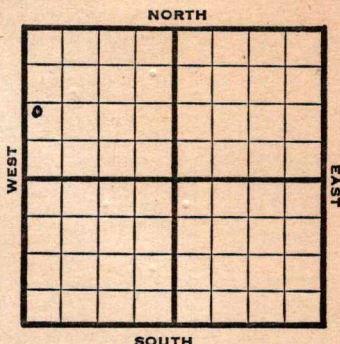

1947

REPORT

10/22

Mach.

10/29

Drlg. 150'

11/5

Drlg. 655'

11/12

SD.

11/19

12" @ 792'
1400 UR 10

11/25

Drlg. 1520'

12/3

1780' run 8"

12/10

KC 1995
10" @ 1330
8" @ 1740
Drlg. 2100

12/17

Drlg. 2340'

12/30

Miss. 2774'
7" @ 2778'
TD 280₇'

1948

1/7

"

1/14

"

1/21

"

1/26

"

2/4

"

OVER

1948

2/11 Miss 2774'

7" @ 778'

TD 2801'

2/18 "

2/25 Miss. 2774'

7" @ 2778'

500 acid

Pump 15 Pot

38.0 Gr.

TD 2801'

Comp.

COMPLETED

Map No. _____ Sec. **20** Twp. **29** R. **8E**

Well No. **1 Hoard**

K. T. Weidemann

Company

FIRST REPORT

Contractor

NW SW NE

SECTION PLAT

o			

_____ Ft. from N. Line

990 _____ Ft. from S. Line

_____ Ft. from E. Line

330 _____ Ft. from W. Line

Butler County

Location _____

Rig up _____

Drilling and Remarks:

Mach.

RECORD

Cased _____ in., _____ ft.

Sand _____

Gas _____

Oil _____

Total Depth _____

PRODUCTION

1st 24 hrs. Nat. _____

1st 24 hrs. after shot _____

Gas _____ Cu. Ft.

Dry Hole _____

Abandoned _____

Date

OCT 22 1947

19

S. J. LEWIS

Scout

Map No. 10 Sec. 20 Twp. 29 R. 8E

Well No. 1 Hoard

K. T. Weidemann Company

COMPLETE Contractor

NW SW NW

SECTION PLAT

0			

 Ft. from N. Line

990 Ft. from S. Line

 Ft. from E. Line

330 Ft. from W. Line

Butler County

Location

Rig up

Drilling and Remarks:

His 2777
7" @ 2778
5000 ad
Run 1088
0804

RECORD

Cased in., ft.

Sand

Gas

Oil ✓

Total Depth 2801

PRODUCTION

1st 24 hrs. Nat.

1st 24 hrs. after shot

Gas Cu. Ft.

Dry Hole

Abandoned

Date

FEB 25 1948

19

S. J. LEWIS Scout