
Form 51 5M 8-24 16567

Map No. Kan Sec. 19 Twp. 23 R. 9

Well No. 1 Morris Farm

White Eagle & McGinnis Company

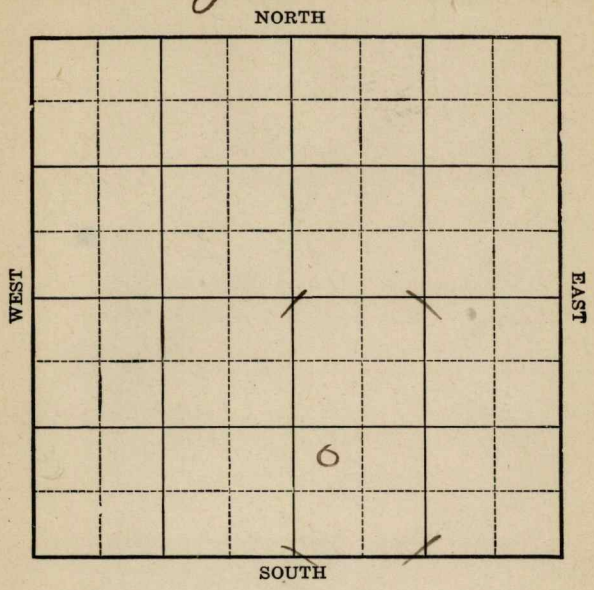

Location

Drilling Remarks

Rig Up

Drilling Remarks

RECORD

Cased in. ft.

Sand

Gas

Oil

Total Depth

PRODUCTION

1st 24 hrs. Nat.

1st. 24 hrs. after shot

Gas cu. ft.

Dry Hole


Abandoned

Form 252A 5M 8-24 16529

Map No. Kaw Sec. 19 Twp. 22 R 9

Well No. 1 Morris Farm

White Eagle & McGinnis Company

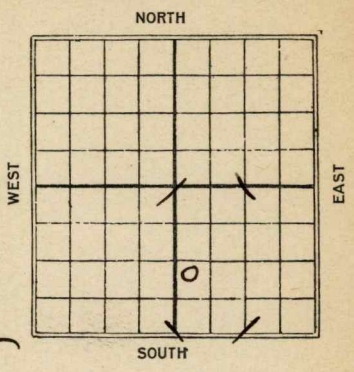

____ Ft. from N. Line

990 Ft. from S. Line

____ Ft. from E. Line

330 Ft. from W. Line

C

Date 1925	REPORT
7/17	R.O.G.
7/24	bldg. Rig.
7/31	Rig
8/7	Rigging up
8/14	spud.
8/20	650'
8/26	1500'
9/3	set 6" 2227 Arlg. @ 2323'
9/11	Top s. 2526 - 62' Broken sand 2562 - 67 sand 2567 2586 swabbing 8 bbls per hr. Will shoot
9/19	Top sand 2526 - 62 Bkn. sand 2562 - 67 Sand 2567 - 86 60 gts 150 Bbls

Form 26—1M Bks.—3-23—11959.

Map No. 1 Sec. 19 Twp. 23 R. 9


Well No. 1 Morris

White Eagle & McDonnis Company

Contractor

FIRST REPORTS

SECTION PLAT

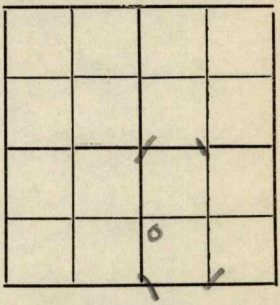

_____Ft. from N. Line

990 Ft. from S. Line

_____Ft. from E. Line

330 Ft. from W. Line

Location _____

Rig up on ground

Drilling and Remarks:

RECORD

Cased _____ in., _____ ft.

Sand _____

Gas _____

Oil _____

Total Depth _____

PRODUCTION

1st 24 hrs. Nat. _____

1st 24 hrs. after shot _____

Gas _____ Cu. Ft.

Dry Hole _____

Abandoned _____

Date

JUL 17 1925

_____ 192____.

CHAS. L. SHERWOOD

_____ Scout

Form 26—1M Bks.—3-23—11959. Glenwood Co

Map No. KANSAS Sec. 19 Twp. 22 R. 9


Well No. 11 J. Morris

White Eagle & McGinnis Company

Contractor

COMPLETED

SECTION PLAT

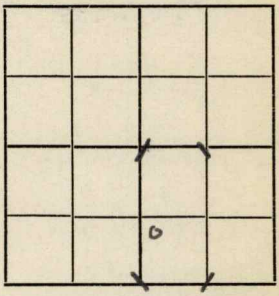

_____Ft. from N. Line

990 Ft. from S. Line

_____Ft. from E. Line

330 Ft. from W. Line

Location _____

Rig up _____

Drilling and Remarks:

Top Ad 2526-62'

Brown Ad 2562-67'

Miss 2567-86'

60/150 bbls

RECORD

Cased _____ in., _____ ft.

Sand _____

Gas _____

Oil _____

Total Depth 2586'

PRODUCTION

1st 24 hrs. Nat. _____

1st 24 hrs. after shot. _____

Gas _____ Cu. Ft.

Dry Hole _____

Abandoned _____

Date

SEP 19 1925 192

CHAS. L. SHERWOOD Scout