


Greenwood Co
Map No. *Kansas* Sec. *19* Twp. *23* R. *9*
Well No. *4 Morris* Farm
White Eagle & McGinnis Company

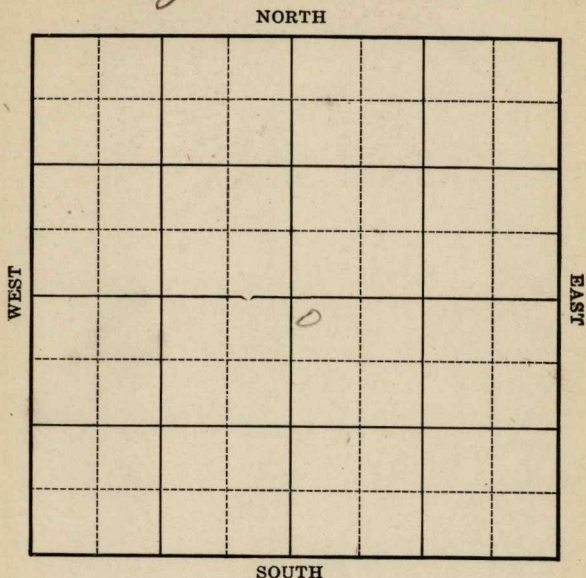

Location _____

Drilling Remarks _____

Rig Up _____

Drilling Remarks _____

RECORD

Cased _____ in. _____ ft.

Sand _____

Gas _____

Oil _____

Total Depth _____

PRODUCTION

1st 24 hrs. Nat. _____

1st 24 hrs. after shot _____

Gas _____ cu. ft.

Dry Hole _____

Abandoned _____


Map No. **KANSAS** Sec. **19** Twp. **23** R. **9**
 Well No. **4 Morris** Farm
White Eagle Company

250 Ft. from N. Line

_____ Ft. from S. Line

_____ Ft. from E. Line

250 Ft. from W. Line

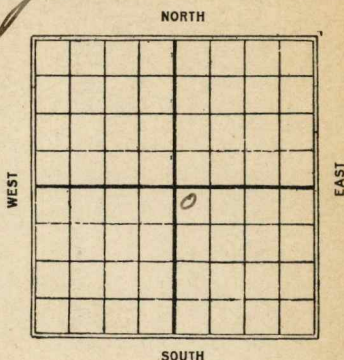

1925

Date

REPORT

10/22 Bldg Rig

10/29 Rig

11/6 Regin up

11/13

11/19

11/27 950

12/3 1035

12/10

12/17 Only 1470'

12/23

12/31 Only 1750'

1926

1/8 Runny 8' 14 2220'

**1/14 T.S. 2593' 2 feet in
underreaming**

1/20 Abandoned 2627

K12 **KANSAS** Map No. _____ Sec. 19 Twp. 23 R. 9

Well No. 4 Morris _____ Company _____ Contractor _____

SECTION PLAT

250 Ft. from N. Line

_____ Ft. from S. Line

_____ Ft. from E. Line

250 Ft. from W. Line

FIRST REPORTS

Location _____

Rig up _____

Drilling and Remarks:

Blag Big

RECORD

Cased _____ in., _____ ft.

Sand _____

Gas _____

Oil _____

Total Depth _____

PRODUCTION

1st 24 hrs. Nat. _____

1st 24 hrs. after shot _____

Gas _____ Cu. Ft.

Dry Hole _____

Abandoned _____

Date

OCT 22 1925

CHAS. L. SHERWOOD

192

Scout


K/S Map No. **KANSAS** Sec. **19** Twp. **23** R. **9**

Well No. **4 Morris**
White Eagle oil et al Company
 Contractor

COMPLETED

SECTION PLAT

250 Ft. from N. Line
 _____ Ft. from S. Line
 _____ Ft. from E. Line
250 Ft. from W. Line

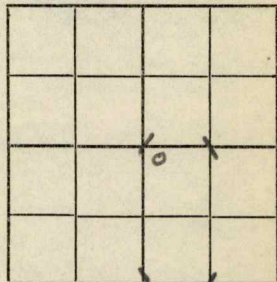

ABANDONED

Location _____

Rig up _____

Drilling and Remarks

Dry & abandoned

L.D. 2627

RECORD

Cased _____ in. _____ ft.

Sand **2593-2595**

Gas _____

Oil _____

Total Depth **2627**

PRODUCTION

1st 24 hrs. Nat. _____

1st 24 hrs. after shot. _____

Gas _____ Cu. Ft.

Dry Hole ☒Abandoned ☒

Date

JAN 20 1926

CHAS. L. SHERWOOD

192

Scout