


Map No. Kansas Sec. 19 Twp. 23 R. 9 Greenwood Co
Well No. 3 Morris Farm White Eagle & Mc Ginnis Company

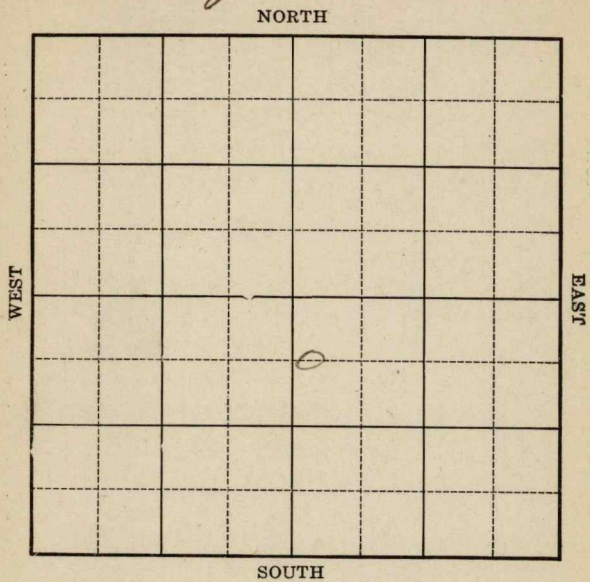

Location _____

Drilling Remarks _____

RECORD

Cased _____ in. _____ ft.

Sand _____

Gas _____

Oil _____

Total Depth _____

Rig Up _____

Drilling Remarks _____

PRODUCTION

1st 24 hrs. Nat. _____

1st 24 hrs. after shot _____

Gas _____ cu. ft.

Dry Hole _____

Abandoned _____

Map No. **KANSAS** Sec. **19** Twp. **23** R. **9**
 Well No. **3 Morris** Farm
White Eagle & McGinnis Company

NORTH

660' Ft. from N. Line


Ft. from S. Line

Ft. from E. Line

330 Ft. from W. Line

WEST

EAST

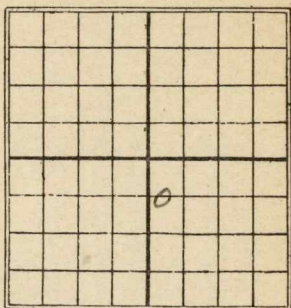

SOUTH

1925

Date

REPORT

9/25	Location
10/1	—
10/8	Bldg rig
10/16	Red
10/22	spudding too
10/29	5-70
11/6	1000
11/13	1050
11/19	—
11/27	Fishing 1635'
12/3	—
12/10	—
12/17	—
12/23	shidding rig, Total depth all hole 1635'
12/31	shidded rig. T.D. old hole 1635' Bldg rig
1926	
1/8	Rig
1/14	Drilg 375'
1/20	✓ 900'
1/27	—

2/4 - Dlg 1450'

2/10 - ✓ 1725'

2/17 Dlg 2300

3/3 - Sand 2528-2567
80 gts 200 barrels

Map No. **KANSAS** Sec. *19* Twp. *23* R. *9*Well No. *13* *Morris*
White Eagle & McPinnis Company

Contractor

FIRST REPORTS

660 Ft. from N. Line

Ft. from S. Line

Ft. from E. Line

330 Ft. from W. Line

SECTION PLAT

		o	

Location ✓

Rig up

Drilling and Remarks:

RECORD

Cased _____ in., _____ ft.

Sand _____

Gas _____

Oil _____

Total Depth _____

PRODUCTION

1st 24 hrs. Nat. _____

1st 24 hrs. after shot _____

Gas _____ Cu. Ft.

Dry Hole _____

Abandoned _____

Date

SEP 25 1925

192

CHAS. L. SHERWOOD

Scout

K15 **KANSAS** *19* Sec. *23* Twp. *9* R. *9*

Well No. *3* *Monnie*
White Eagle & McBurnie Company

Contractor

COMPLETED

SECTION PLAT

660 Ft. from N. Line

Ft. from S. Line

Ft. from E. Line

330 Ft. from W. Line

		<i>1</i>	<i>1</i>
		<i>0</i>	

Location

Rig up

Drilling and Remarks:

80y 200 ft.

RECORD

Cased in., *2529-2567* ft.

Sand

Gas

Oil

Total Depth *2567*

PRODUCTION

1st 24 hrs. Nat.

1st 24 hrs. after shot

Gas Cu. Ft.

Dry Hole

Abandoned

Date

MAR 3 1926

CHAS. L. SHERWOOD

192

Scout