

KANSAS


Marion county

FORM 51 IOM 12-46 PETROL

Section 27 Township 19 Range 1-E

Well No. #2, Weyand

Company Anderson-Prichard

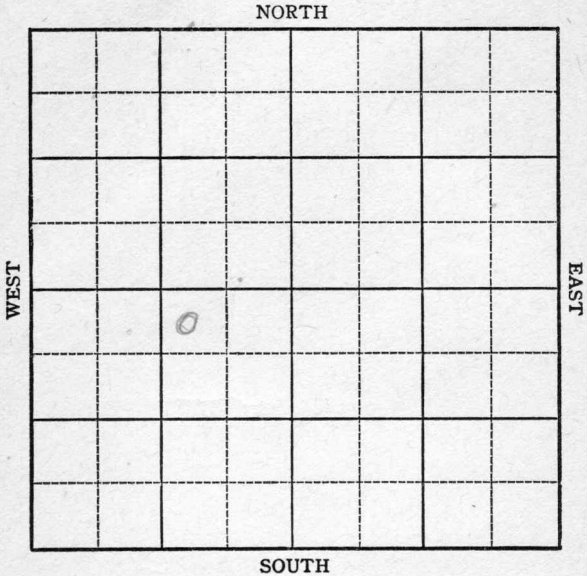

Sec. 27 Twp. 19 R. 1-EWell No. #2, Weyand FarmAnderson-Prichard


Company

Leigh Pool330' Ft. from N. Line

Ft. from S. Line

990' Ft. from E. Line

Ft. from W. Line

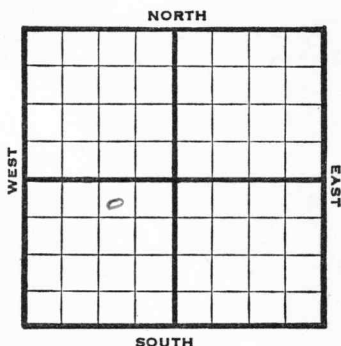

NW NE SW

|       | REPORT   |
|-------|---|
| 1946  | Elev. 1525   |
| 12/4  | 8" @ 162'<br>Miss. 2794'<br>Drlg. 2900'.                                                                            |
| 12/10 | Viola 3233'<br>Simp 3303<br>5" @ 3303'<br>TD 3305 RUST                                                              |
| 12/17 | Arb 3359-84 TD<br>PB                                                                                                |
| 1947  |   |
| 1/4   | PB 3251'<br>33 shots 3222-26<br>500 acid, swb 9 fluid<br>PH 25% W                                                   |
| 1/8   | " " "   |
| 1/15  | " " "   |
| 1/21  | Pump 47 oil To 20% water<br>in 17 hrs                                                                               |
| 1/29  | Viola 3223<br>Arb 3359<br>5" @ 3303<br>Perf Viila<br>500 Acid<br>Pump 206 oil to 9% W Pot<br>44 Gravity<br>TD 3384' |
|       | COMPLETED   |

Map No. 24 Sec. 27 Twp. 19 R. 1E

Well No. 2 Weyand

Anderson-Prichard Company

FIRST REPORT

Contractor

NW NE SW

SECTION PLAT

|  |  |  |  |
|--|--|--|--|
|  |  |  |  |
|  |  |  |  |
|  |  |  |  |
|  |  |  |  |

330 Ft. from N. Line

\_\_\_\_\_ Ft. from S. Line

990 Ft. from E. Line

\_\_\_\_\_ Ft. from W. Line

Marion County

Location \_\_\_\_\_

Rig up \_\_\_\_\_

Drilling and Remarks:

8" @ 162

Miss. 2794

drlg. 2900

RECORD

Cased \_\_\_\_\_ in., \_\_\_\_\_ ft.

Sand \_\_\_\_\_

Gas \_\_\_\_\_

Oil \_\_\_\_\_

Total Depth \_\_\_\_\_

PRODUCTION

1st 24 hrs. Nat. \_\_\_\_\_

1st 24 hrs. after shot \_\_\_\_\_

Gas \_\_\_\_\_ Cu. Ft.

Dry Hole \_\_\_\_\_

Abandoned \_\_\_\_\_

Date

DEC 4 1946

19

S. J. LEWIS

Scout

Map No. 24 Sec. 27 Twp. 19 R. 1E

Well No. 2 Weyand

Anderson-Prichard Company

**COMPLETE**

Contractor

NW NE SW


*E1, 1525*  
**SECTION PLAT**

330 Ft. from N. Line

\_\_\_\_\_ Ft. from S. Line

990 Ft. from E. Line

\_\_\_\_\_ Ft. from W. Line

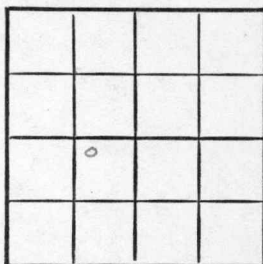

Marion County

Location \_\_\_\_\_

Rig up \_\_\_\_\_

Drilling and Remarks:


**RECORD**

Cased \_\_\_\_\_ in., \_\_\_\_\_ ft.

Sand \_\_\_\_\_

Gas \_\_\_\_\_

Oil \_\_\_\_\_

Total Depth 3384

**PRODUCTION**

1st 24 hrs. Nat. \_\_\_\_\_

1st 24 hrs. after shot \_\_\_\_\_

Gas \_\_\_\_\_ Cu. Ft.

Dry Hole \_\_\_\_\_

Abandoned \_\_\_\_\_

Date

JAN 29 1947 19

S. J. LEWIS Scout