


Map No. Kansas Greenwood Sec. 19 Twp. 23 R. 9 ✓
Well No. 5 Morris Farm
Phillips Pet Company

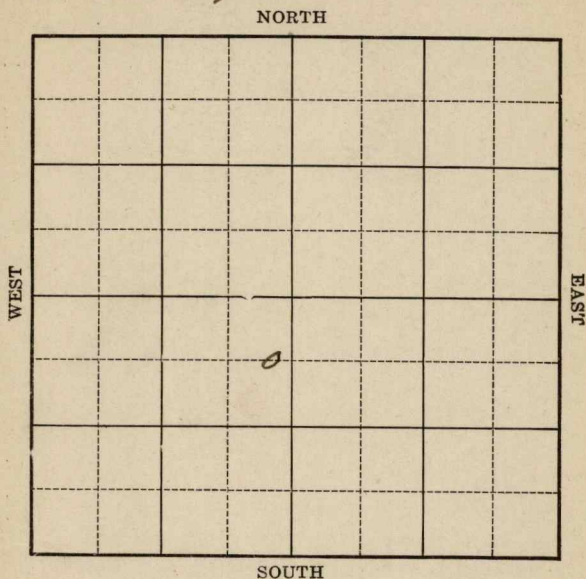

Location _____

Drilling Remarks _____

Rig Up _____

Drilling Remarks _____

RECORD

Cased _____ in. _____ ft.

Sand _____

Gas _____

Oil _____

Total Depth _____

PRODUCTION

1st 24 hrs. Nat. _____

1st 24 hrs. after shot _____

Gas _____ cu. ft.

Dry Hole _____

Abandoned _____

Greenwood


Map No. **KANSAS** Sec. 19 Twp. 23 R. 9Well No. 5 Morris Farm
Phillips Pet Company

660' Ft. from N. Line

Ft. from S. Line

330' Ft. from E. Line

Ft. from W. Line

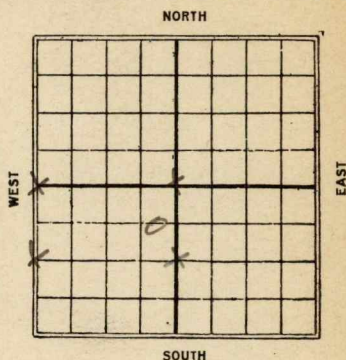

1925

Date

REPORT

10/8 Rig
 10/16 Rigging up
 10/22 Drily @ 350'
 10/29 Running 12" x 935'
 11/6 1120
 11/13 1665
 11/19 1980
 11/27 2250
 12/3 Set 6" Jap Ad 2569- 20. 2599'
 Filled up 400 oih Nat. Well shoot
 12/10 Sand 2569- 2612
 110 gts 50 Bbls

K15 **KANSAS** Sec. *19* Twp. *23* R. *9*

Well No. *15 Morris*

Phillips *pet* Co. Company

Contractor

FIRST REPORTS


SECTION PLAT

660 Ft. from N. Line

_____ Ft. from S. Line

330 Ft. from E. Line

_____ Ft. from W. Line

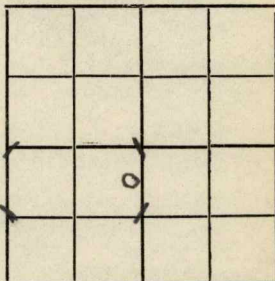

Location _____

Rig up ☒

Drilling and Remarks:

RECORD

Cased _____ in., _____ ft.

Sand _____

Gas _____

Oil _____

Total Depth _____

PRODUCTION

1st 24 hrs. Nat. _____

1st 24 hrs. after shot _____

Gas _____ Cu. Ft.

Dry Hole _____

Abandoned _____

Date

OCT 8 1925

192

CHAS. L. SHERWOOD


Scout

Sherwood Co

Map No. KANSAS ¹⁵ Sec. 19 Twp. 23 R. 9Well No. 5 Morris
Phillips Pet Co Company

Contractor

SECTION PLAT

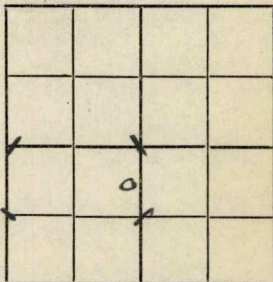660 Ft. from N. Line330 Ft. from S. Line330 Ft. from E. Line Ft. from W. Line

COMPLETED

Location Rig up

Drilling and Remarks:

1st oil 2581'1109 50 bhs

RECORD

Cased in., ft.Sand 2569-2612'Gas Oil Total Depth 2612'

PRODUCTION

1st 24 hrs. Nat. 1st 24 hrs. after shot Gas Cu. Ft.Dry Hole Abandoned

Date

DEC 10 1925

192

CHAS. L. SHERWOOD

Scout