


Greenwood Co
Kansas
Map No. _____ Sec. 19 Twp. 23 R. 9
Well No. 6 Morris Farm
Mission Oil Company

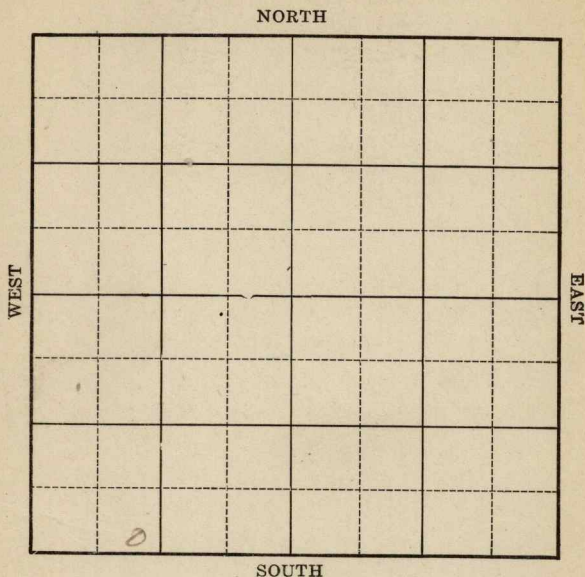

Location _____

Drilling Remarks

Rig Up _____

Drilling Remarks

RECORD

Cased _____ in. _____ ft.

Sand _____

Gas _____

Oil _____

Total Depth _____

PRODUCTION

1st 24 hrs. Nat. _____

1st 24 hrs. after shot _____

Gas _____ cu. ft.

Dry Hole _____


Abandoned _____

Greenwood Co.
 Map No. Kansas Sec. 19 Twp. 23 R. 9
 Well No. 6 Morris Farm
Mission Oil Company

Ft. from N. Line

330 Ft. from S. Line

Ft. from E. Line

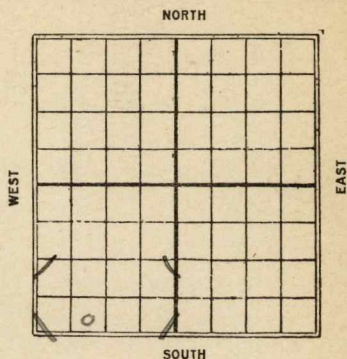990 Ft. from W. Line


Date	REPORT
<u>1925</u>	
<u>11/13</u>	<u>Location</u>
<u>11/19</u>	<u>Blsg Rq</u>
<u>11/27</u>	<u>—</u>
<u>12/3</u>	<u>Rq</u>
<u>12/10</u>	<u>Rigging up</u>
<u>12/17</u>	<u>Spudded & S. D.</u>
<u>12/23</u>	<u>—</u>
<u>12/31</u>	<u>—</u>
<u>1926</u>	
<u>1/8</u>	<u>—</u>
<u>1/14</u>	<u>—</u>
<u>1/20</u>	<u>—</u>
<u>1/27</u>	<u>—</u>
<u>2/4</u>	<u>—</u>
<u>2/10</u>	<u>—</u>
<u>2/17</u>	<u>—</u>
<u>2/24</u>	<u>—</u>
<u>3/5</u>	<u>—</u>
<u>3/10</u>	<u>—</u>
<u>3/18</u>	<u>—</u>
<u>3/25</u>	<u>—</u>
<u>4/1</u>	<u>Rigging up.</u>

4/7- Drilling 250
4/14- " 1110
4/21 " 1670.
4/30 " 2280.
5/5 Ad. 2595-2614. J.D. 35/40

K15
 Map No. **KANSAS** Sec. *19* Twp. *22* R. *9*

Well No. *6 Morris*
Mission oil Co Company

Contractor

FIRST REPORTS

SECTION PLAT

Ft. from N. Line

330

Ft. from S. Line

Ft. from E. Line

990

Ft. from W. Line

Location ☒

Rig up

Drilling and Remarks:

RECORD

Cased _____ in., _____ ft.

Sand _____

Gas _____

Oil _____

Total Depth _____

PRODUCTION

1st 24 hrs. Nat. _____

1st 24 hrs. after shot _____

Gas _____ Cu. Ft.

Dry Hole _____

Abandoned _____

Date

NOV 13 1925

192

CHAS. L. SHERWOOD

Scout

Shenwood
 Map No. *K15* KANSAS Sec. *19* Twp. *23* R. *9*
 Well No. *6 Morris*
Mission Oil Co. Company

Contractor

COMPLETED

SECTION PLAT

Ft. from N. Line


330

Ft. from S. Line

Ft. from E. Line

990

Ft. from W. Line

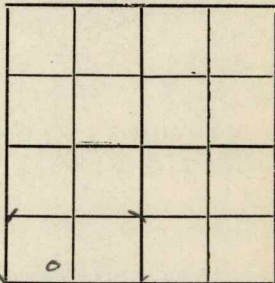

Location

Rig up

Drilling and Remarks:

RECORD

Cased in, ft.

Sand *2595-2614*

Gas

Oil

Total Depth *2614*

PRODUCTION

1st 24 hrs. Nat.

1st 24 hrs. after shot

Gas Cu. Ft.

Dry Hole

Abandoned

Date

MAY 5 1926

CHAS. L. SHERWOOD

192

Scout