


Section 30 Township 27 Range 2-E

Well No. #2 Rimel

Company Bachus & Sons

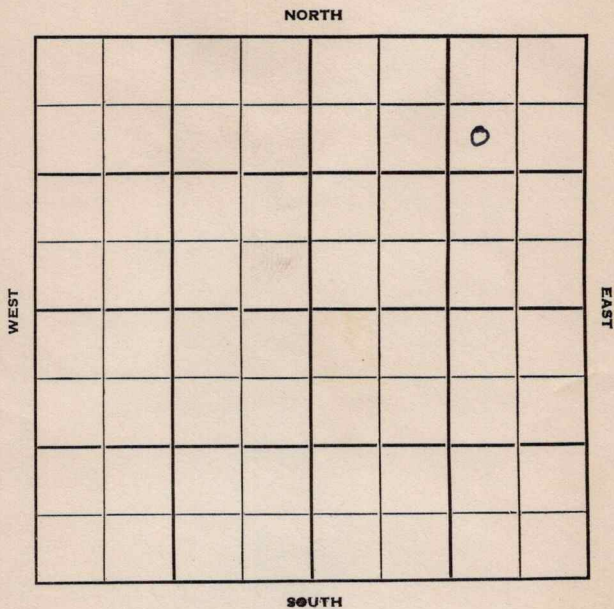

Sedgwick

KANSAS

Sec. 30 Twp. 27 R. 2E

Well No. #2 Rimel Farm

Bachus & Sons Company

Crest Pet. - Contr. Contractor

Eastborough Pool


990' Ft. from N. Line

 Ft. from S. Line

990' Ft. from E. Line

 Ft. from W. Line

SW NE NE

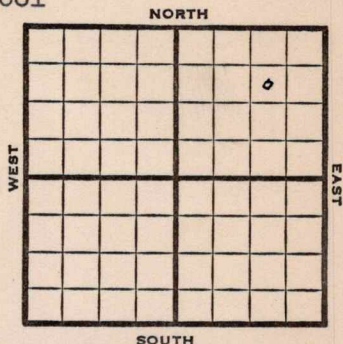

1950

REPORT

11/15 Spud 11-14-50
Drlg.

1951
1/10 Spud 11-14-50
8" @ 83

KC 2495

Miss 2934

5½" @ 2936

TD 2969

SP 2959

30 qt 2949-59

D&A

ABANDONED

County Sedgwick State KansasSec. 30 (Blk.) 27 (Sur.) 2E Map No.Operator Bachus & SonsWell No. 2 Farm RimelElev. _____ Location SW NE NE

990 Ft. From N Line NE990 Ft. From E Line Quarter

NOV 15 1950


1st. Report _____

Completion _____

Remarks _____

Crest Pet. - Contr.Spudding Date 11-14-50Drlg. Data Eastborough Pooldrlg.

J. E. TYRA

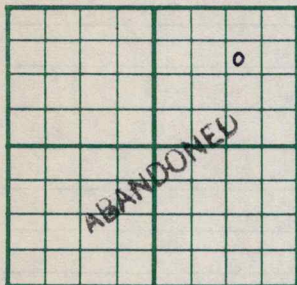County Sedgwick State KansasSec. 30 (Blk.) 27 (Sur.) 2E Map No.Operator Bachus & SonsWell No. 2 Farm RimelElev. Location SW NE NE990 Ft. From N Line NE990 Ft. From E Line Quarter

1st. Report

Completion JAN 10 1951Remarks Eastborough PoolCrest Pet. - Contr.Spudding Date 11-14-50Drlg. Data D & A TD 29698" @ 83 KC 2495 Miss. 2934 5 $\frac{1}{2}$ " @ 2936TD 2969 SP 2959 30 qt/ 2949-59D & A

J. E. TYRA