


Map No. 1 Sec. 20 Twp. 23 R. 9
Well No. 1 Cain Farm
Phillips Pet Company

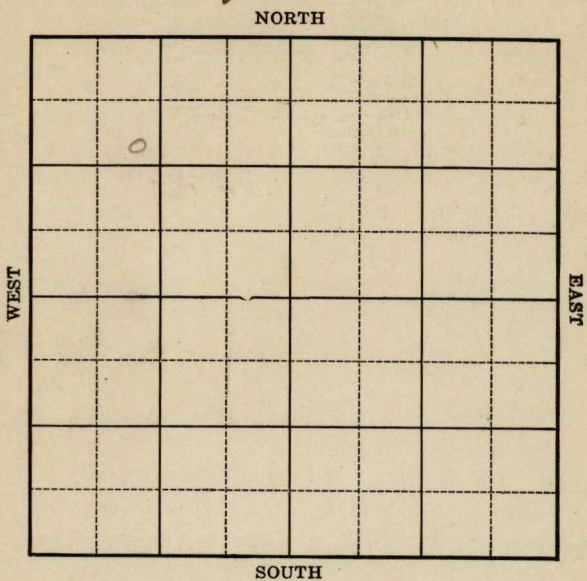

Location _____

Drilling Remarks _____

Rig Up _____

Drilling Remarks _____

RECORD

Cased _____ in. _____ ft.

Sand _____

Gas _____

Oil _____

Total Depth _____

PRODUCTION

1st 24 hrs. Nat. _____

1st 24 hrs. after shot _____

Gas _____ cu. ft.

Dry Hole _____

Abandoned _____

K15 **KANSAS** Sec. 20 Twp. 23 R. 9

Well No. 1 Chin
Phillips Pet Co. Company

Contractor

SECTION PLAT

990 Ft. from N. Line

_____ Ft. from S. Line

_____ Ft. from E. Line

990 Ft. from W. Line

FIRST REPORTS

Location ✓

Rig up _____

Drilling and Remarks:

RECORD

Cased _____ in., _____ ft.

Sand _____

Gas _____

Oil _____

Total Depth _____

PRODUCTION

1st 24 hrs. Nat. _____

1st 24 hrs. after shot _____

Gas _____ Cu. Ft.

Dry Hole _____

Abandoned _____

Date

OCT 22 1925

192

CHAS. L. SHERWOOD

Scout


Map No. **KANSAS** ¹⁵ See ²⁰ Twp. ²³ R. ⁹

Well No. ¹ *Chin* _____

Phillips pet Co. _____ Company

_____ Contractor

SECTION PLAT

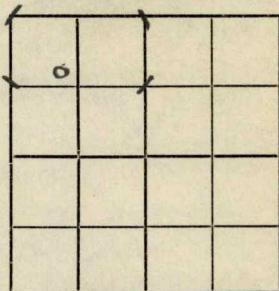

990 _____ Ft. from N. Line

_____ Ft. from S. Line

_____ Ft. from E. Line

990 _____ Ft. from W. Line

COMPLETED

Location _____

Rig up _____

Drilling and Remarks:

oil 2511'
110/20 bhs
some water.

RECORD

Cased _____ in., _____ ft.

Sand *2494-2564'*

Gas _____

Oil _____

Total Depth *2567'*

PRODUCTION

1st 24 hrs. Nat. _____

1st 24 hrs. after shot _____

Gas _____ Cu. Ft.

Dry Hole _____

Abandoned _____

Date

DEC 23 1925

192

CHAS. L. SHERWOOD

Scout