

KANSAS


FORM 51 IOM 12-46 PETROL

Greenwood count

Section 10 Township 23 Range 13-E

Well No. #30, Schneider

Company Barbara Oil Company

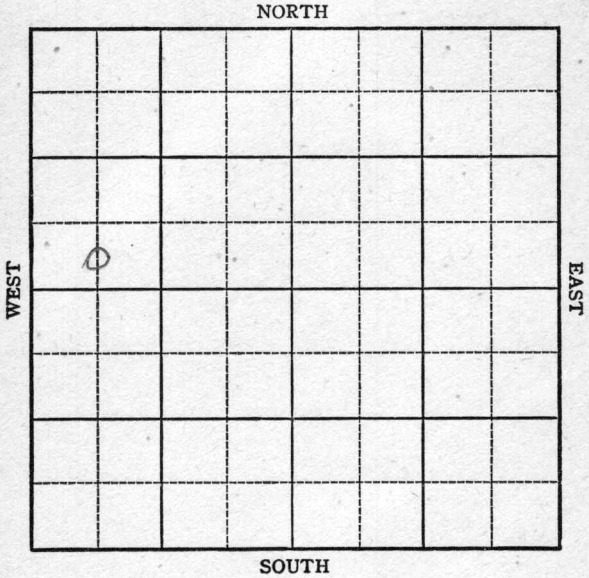

KANSAS

Greenwood

Sec. 10 Twp. 23 R. 13-E


Well No. #30, Schneider Farm
Barbara Oil Company Company
Virgil Pool

Ft. from N. Line

330' Ft. from S. Line

Ft. from E. Line

660' Ft. from W. Line

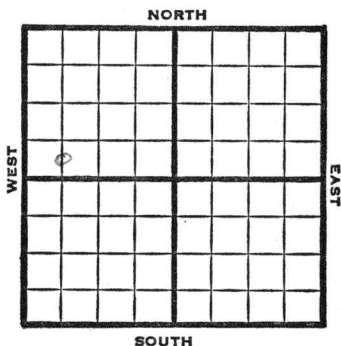

C SL SW NW

REPORT

1947

1/22

Miss. 1770'
T.D. 1783'
5" @ 1772'

1/29

TD 1785'
Miss 1770
5" @ 1772
1000 Acid
Pump 25 Bot
36 Gravity

COMPLETED

Map No. 17 Sec. 10 Twp. 23 R. 13EWell No. 30 SchneiderBarbara Oil

Company

FIRST REPORT

Contractor

C S L SW NW

SECTION PLAT

o			

 Ft. from N. Line330 Ft. from S. Line Ft. from E. Line660 Ft. from W. LineGreenwood CountyLocation Rig up

Drilling and Remarks:

Miss. 1770

TD 1783

5" @ 1772

RECORD

Cased in., ft.Sand Gas Oil Total Depth

PRODUCTION

1st 24 hrs. Nat. 1st 24 hrs. after shot Gas Cu. Ft.Dry Hole Abandoned

Date

JAN 22 194719S. J. LEWISScout

Map No. 17 Sec. 10 Twp. 23 R. 13E

Well No. 30 Schneider

Barbara Oil


Company

COMPLETE

Contractor

C S L SW NW

SECTION PLAT

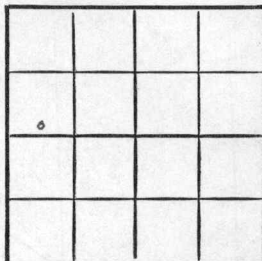

 Ft. from N. Line

330 Ft. from S. Line

 Ft. from E. Line

660 Ft. from W. Line

Greenwood County

Location

Rig up

Drilling and Remarks:

*Miss 1770
 5" @ 1772.
 1000 acid
 Pump 25 Bbl*

36 Cu

RECORD

Cased in., ft.

Sand

Gas

Oil

Total Depth 1785

PRODUCTION

1st 24 hrs. Nat.

1st 24 hrs. after shot

Gas Cu. Ft.

Dry Hole

Abandoned

Date

JAN 29 1947 19

S. J. LEWIS

Scout