


KANSAS

Sedg

Form 51-5M-2-29-34703

Map No. _____ Sec. *31* Twp. *27* R. *2E*

Well No. *1- Drollinger* Farm _____
Blackwell Pet Company _____

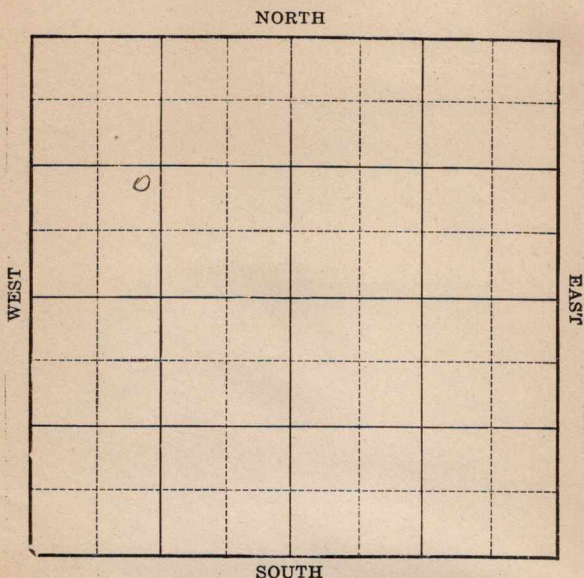

Location _____
Drilling Remarks _____

Rig Up _____
Drilling Remarks _____

RECORD


Cased _____ in. _____ ft.
Sand _____
Gas _____
Oil _____
Total Depth _____

PRODUCTION

1st 24 hrs. Nat. _____
1st 24 hrs. after shot _____
Gas _____ cu. ft.
Dry Hole _____
Abandoned _____

Map No. KANSAS Sec. 31 Twp. 27 R. 2^E
 Well No. 1- Drollinger Farm
Blackwell Co. Company

NORTH

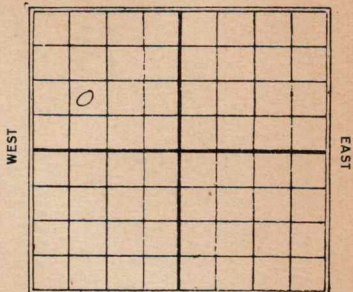

Ft. from N. Line

990 Ft. from S. Line

Ft. from E. Line

990 Ft. from W. Line

1930

SOUTH

Date

REPORT

8/20	Cellar
8/27	Run
9/3	Relg. 540'
9/10	" 1105'
9/17	" 1670'
9/24	" 2425'
10/1	S.D. 2590'
10/8	Run 8"- 2580'
	TD 2590'
10/15	SD 2600'
10/22	—
10/29	—
11/5	—
11/12	—
11/19	Only 2665'
11/25	Run 6"- 2954'
12/3	Chat 2951'
	HFW 2956'
	Only 3115'
12/10	Run 5"- 3235'
	(over)

756476
12/17- Silc lime 3357-60
T.D. 3360
Dry & Abandon

12 **KANSAS** Sec. 31 Twp. 27 R. 2 ^E

Well No. 1 Drilling
Blackwell Petr Co Company

Contractor

FIRST REPORTS

_____ Ft. from N. Line

990 Ft. from S. Line

_____ Ft. from E. Line

990 Ft. from W. Line

SECTION PLAT

0			

Location _____

Rig up Cellar

Drilling and Remarks:

RECORD

Cased _____ in., _____ ft.

Sand _____

Gas _____

Oil _____

Total Depth _____

PRODUCTION

1st 24 hrs. Nat. _____

1st 24 hrs. after shot _____

Gas _____ Cu. Ft.

Dry Hole _____

Abandoned _____

Date

AUG 20 1930

CHAS. L. SHERWOOD


19

Scout

*Sedgwick*Map No. **KANSAS** Sec. *31* Twp. *27* R. *25*Well No. *1 Drilling**Blackwell* Company

Contractor

SECTION PLAT

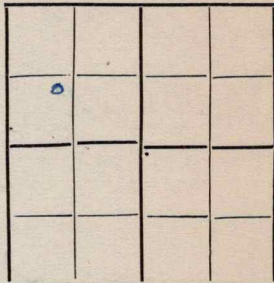

Ft. from N. Line

990 Ft. from S. Line

Ft. from E. Line

990 Ft. from W. Line**ABANDONED**

Location

Rig up

Drilling and Remarks:

*Sil line 3357-60**NFW*

RECORD

Cased _____ in., _____ ft.

Sand _____

Gas _____

Oil _____

Total Depth *3260*

PRODUCTION

1st 24 hrs. Nat. _____

1st 24 hrs. after shot _____

Gas _____ Cu. Ft.

Dry Hole _____

Abandoned _____

Date

DEC 17 1930

192

S. J. LEWIS

Scout