


Section 33 Township 27 Range 2E

Well No. 1 Dotts

Company J. P. Gaty

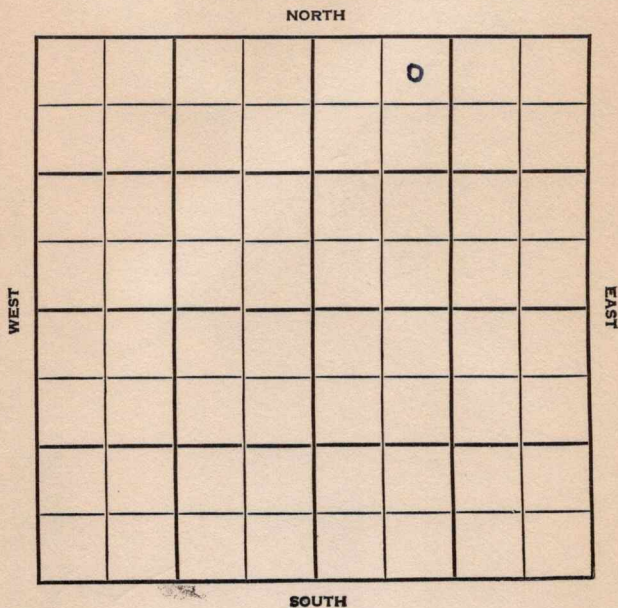

Sedgwick KANSAS

SEC. TWP. R.

WELL NO. 33 27 2 E

COMPANY # 1 Dotts FARM

CONTRACTOR J. P. Gaty

Morrison Wildcat


330 Ft. from N. Line

Ft. from S. Line

Ft. from E. Line

990 Ft. from W. Line

NE NW NE

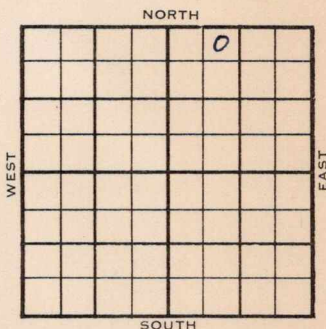

ELEVATION

REPORT

1954

1345'

8/18

Spud 8-13-54  
8" @ 100  
Drlg. 1740'

8/25

Spud 8-13-54 D & A TD 3340  
8" @ 100 Heeb 1900 Stal. 2129  
KC 2472 Marm 2666 Miss 2940  
Kh. 3183 Misener 3236 Viola 3239  
Simp. dol. 3242 Simp. sd 3246  
Arb. 3336 TD 3340  
D & A

**ABANDONED**

County **Sedgwick** State **Kansas**

Sec. **33** (Blk.) **27** (Sur.) **2E** Map No.

Operator **J. P. Gaty**

Well No. **1** Farm **Dotts**

Elev. **1345** Location **NE NW NE**

			0		
FIRST REPORT					

**330** Ft. From **N** Line **NE**

**990** Ft. From **W** Line **Quarter**

1st. Report **AUG 18 1954**

Completion

Remarks

**Morrison - Contr.**

Spudding Date **8-13-54**

Drlg. Data **Wildcat**

**8" @ 100 drlg. 1740**

FABEN GILSTRAP

County Sedgwick State Kansas

Sec. 33 (Blk. 27 (Sur. Rge.) 2E Map No.

Operator J. P. Gaty

Well No. 1 Farm Dotts

Elev. 1345 Location NE NW NE



330 Ft. From N Line NE

990 Ft. From W Line Quarter

Ist. Report AUG 25 1954

Completion Wildcat

Remarks Morrison - Contr.

Spudding Date 8-13-54

Drlg. Data D & A TD 3340

8" @ 100 Heeb. 1900 Stal. 2129

KC 2472 Marm. 2666 Miss. 2940

Kh. 3183 Misener 3236 Viola 3239

Simp. dol. 3242 Simp. sd. 3246

Arb. 3336 TD 3340

D & A

FABEN GILSTRAP