Form 51-5M 5-37 Petrol


Sedgwick

KANSAS

Section 36 Township 27 Range 2-E

Well No. 1-Fee

Company National Ref.

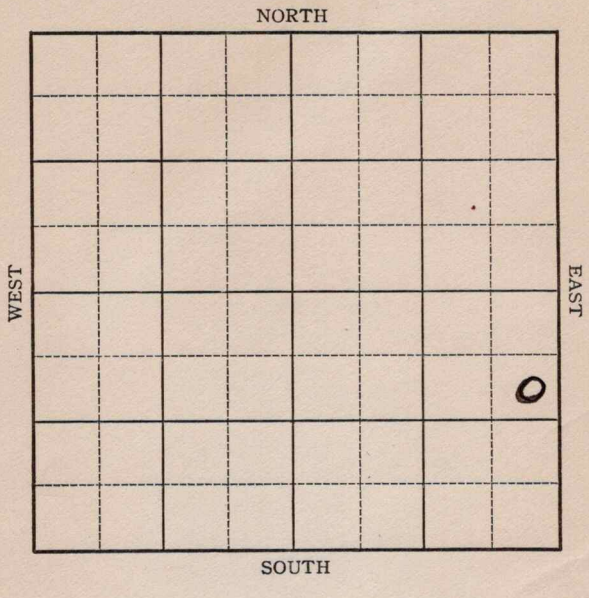

O. W. D. D.

For [illegible]52-A—5M—2-37—Palace KANSAS Sedgwick

Sec. 36 Twp. 27 R. 2-E

Well No. #1 Fee Farm


National Ref. Company

990' Ft. from N. Line

Ft. from S. Line

330' Ft. from E. Line

Ft. from W. Line

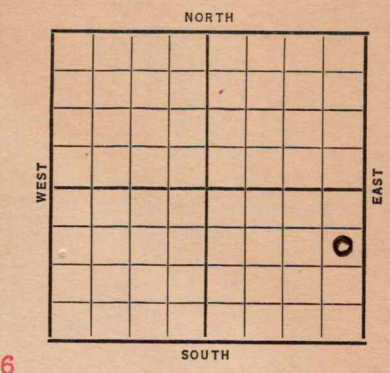

Elev. 1296

Date	REPORT O.W.D.D.
1937	
7/28	Location
8/6	"
8/13	Cellar.
8/20	B. R.
8/28	R. U.
9/3	Spud.
9/10	20" @ 68'. Drlg. 566'.
9/17	12" @ 647'. T.D. 1080' U.R.
9/24	12" @ 1080'. Drlg. 1315'.
10/2	K.C. 1968'. 10" @ 1973'.
	Est. 5½ gas 2000-2016 T.D.
10/8	10" @ 2015'. 2 M gas 2022-25'.
	T.D. 2028'. U.R. 10".
10/15	10" @ 2025'. C.O.
10/22	K.C. 2288'. 8" @ 2354'. WOC.
10/29	S.O. 2380-85'. H.F.W. 2425-40'.
	8" @ 2468'.
11/5	Cong. 2785'. Miss. 2801'.
	T.D. 2875'. H.F.W. 2862-66'.
	Rng. 6".

OVER

756484
756486

1937

11/8--Mississippi 2801 6" 2878
Kinderhook 2930 Wilcox 3087-99 TD
2000 feet oil 600 feet water (Tel)

11/12 Wilcox 3087-98' T.D.
150' oil 12 hrs.
Best Pay 3098-99'.
2600' fluid 16 hrs. 600' water.
Gravity 29.6

11/19 Pump 27 water 1st hr. & 91 oil
& no water next 5 hrs.
5" @ 3087'. P.B. 3098'.

11/26 P.B. 3098'.

12/1 5" @ 3087'.
Wilcox 3087'.
T.D. 3099'.
P.B. 3098'.
Potential 189 bbls. No water.
Gravity 29.6

COMPLETED

1938 O. W. D. D.

6/15 Old T.D. 3099'.
Old Potential 189 bbls.
Drilling deeper.

6/24 " " "

7/1 " " "

7/8 " " "

7/15 Dlg. 3155'.

7/22 Arb. 3188'. T.D. 3201',
No shows. Will P. B.

OVER

1938

7/27 Arb. 3205'.

T. D. 3218' (Correction)

No shows.

P. B. 2501'.

Perf. 2005-12'.

ABANDONED

Form 26 – 1M Bks. – 2-29

KANSAS

Sedgwick

Map No. 12 Sec. 36 Twp. 27 R. 2E

Well No. 1 – Fee

National Ref. Company

Contractor

FIRST REPORT


990 Ft. from N. Line

Ft. from S. Line

330 Ft. from E. Line

Ft. from W. Line

SECTION PLAT

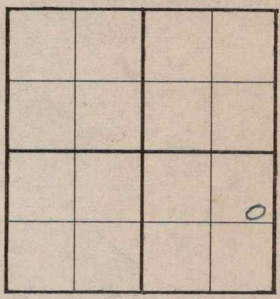

Location ✓

Rig up

Drilling and Remarks:

RECORD

Cased in., ft.

Sand

Gas

Oil

Total Depth

PRODUCTION

1st 24 hrs. Nat.

1st 24 hrs. after shot

Gas Cu. Ft.

Dry Hole

Abandoned

Date

JUL 28 1937 19

H. D. Hatfield Scout

Form 26—1M Bks.—2-29

Sedgwick KANSAS

Map No. 12 Sec. 36 Twp. 27 R. 2E

Well No. 1 Fee

National Refining Company

Contractor

ABANDONED - ?

SE NE SE


990 Ft. from N. Line

Ft. from S. Line

330 Ft. from E. Line

Ft. from W. Line

SECTION PLAT

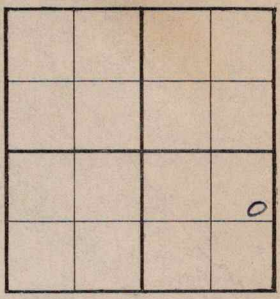

Location

Rig up

Drilling and Remarks:

P.B. 3098

P.O.T. - 189 no wat.

grav 29.6

RECORD

Cased 5 in., 3087 ft.

Sand Wilcox 3087

Gas

Oil

Total Depth 3099

PRODUCTION

1st 24 hrs. Nat.

1st 24 hrs. after shot

Gas Cu. Ft.

Dry Hole

Abandoned

Date

DEC 1 - 1937 19

H. D. Hatfield Scout

Form 26—1M Bks.—2-29 Sedgwick KANSAS

Map No. 12 Sec. 36 Twp. 27 R. 2E

Well No. 1 Fee

National Refining Company

Contractor

FIRST REPORT

SE NE SE


990 Ft. from N. Line

Ft. from S. Line

330 Ft. from E. Line

Ft. from W. Line

SECTION PLAT

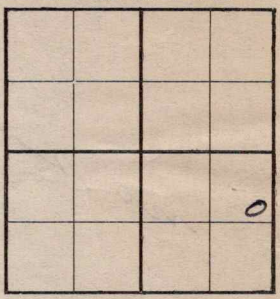

Location

Rig up

Drilling and Remarks:

OWDD-OTD 3099

Old Poten. 189

Drlg. Deeper

RECORD

Cased in., ft.

Sand

Gas

Oil

Total Depth

PRODUCTION

1st 24 hrs. Nat.

1st 24 hrs. after shot

Gas Cu. Ft.

Dry Hole

Abandoned

Date

JUN 15 1938 19

H. D. Hatfield Scout

Form 26—1M Bks.—2-29 Sedgwick KANSAS

Map No. 12 Sec. 36 Twp. 27 R. 2E

Well No. 1 Fee

National Refining Company

Contractor

ABANDONED

SE NE SE


990 Ft. from N. Line

Ft. from S. Line

330 Ft. from E. Line

Ft. from W. Line

SECTION PLAT

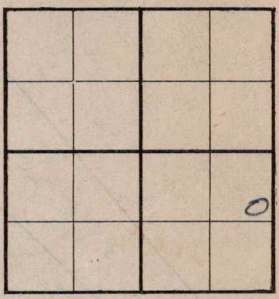

Location

Rig up

Drilling and Remarks:

Correction
3201 = 18

No shows
PB 2501
Perf - 2005-12
DTA

RECORD

Cased in., ft.

Sand Arb 3205

Gas

Oil

Total Depth 3218

PRODUCTION

1st 24 hrs. Nat.

1st 24 hrs. after shot

Gas Cu. Ft.

Dry Hole

Abandoned

Date

JUL 27 1938 19

H. D. Hatfield Scout