

Well No. 1 Morris Farm

P. Phillips Pet Company

W

S

Location -----

Drilling Remarks:

Rig Up -----

Drilling Remarks:

RECORD

Cased ----- in.-----ft.

Sand -----

Gas _____

Oil -----

Total Depth.....

PRODUCTION

1st 24 hrs. Nat.-----

1st 24 hrs. after shot-----


Gas ----- cu. ft.

Dry Hole -----

Abandoned -----

Map No. _____ Sec. 20²⁰ Twp. 23 R. 9Well No. 1. Morris. Farm _____Phillips Per. Company _____1120 Ft. from N. Line1120 Ft. from S. Line200 Ft. from E. Line

_____ Ft. from W. Line

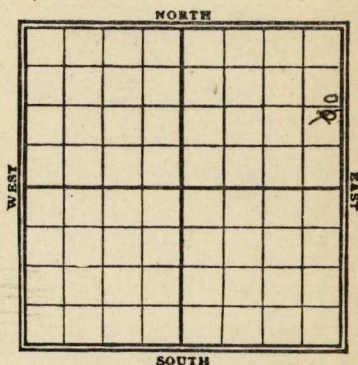

Date

REPORT

1/2/20

Rig up.

16

DR 1500'

24

Dreg. 1850'

21

Sub 2590'

8

Sub 2680'

12

Dry abandoned 2665'

COMPLETED

Map No. K 15 Sec. 20 Twp. 23 R. 9Well No. 1 MorrisPhillips Pet Company

Contractor

SECTION PLAT

----- Ft. from N. Line

1120 Ft. from S. Line200 Ft. from E. Line

----- Ft. from W. Line

FIRST REPORT

Location -----

Rig up ☒ -----

Drilling and Remarks:

RECORD

Cased ----- in., ----- ft.

Sand -----

Gas -----

Oil -----

Total Depth -----

PRODUCTION

1st 24 hrs. Nat. -----

1st 24 hrs. after shot -----

Gas ----- Cu. Ft.

Dry Hole -----

Abandoned -----

Date

Pyle

1/2 1919

Scout

Map No. 15 Sec. 20 Twp. 23 R. 9Well No. 1 Morris
Phillips Pet Company

Contractor

SECTION PLAT

1120 Ft. from N. Line

Ft. from S. Line

200 Ft. from E. Line

Ft. from W. Line

			0

Location Change

Rig up

Drilling and Remarks:

1119 1500'

RECORD

Cased _____ in., _____ ft.

Sand _____

Gas _____

Oil _____

Total Depth _____

PRODUCTION

1st 24 hrs. Nat. _____

1st 24 hrs. after shot _____

Gas _____ Cu. Ft.

Dry Hole _____

Abandoned _____

Date

1/16 19120

Pyle

Scout

Map No. K 15 Sec. 20 Twp. 23 R. 9Well No. 1 MorrisPhillips Pet Company

Contractor

SECTION PLAT

Ft. from N. Line

1120 Ft. from S. Line200 Ft. from E. Line

Ft. from W. Line

			Ø

COMPLETED

Location

Rig up

Drilling and Remarks:

RECORD

Cased _____ in., _____ ft.

Sand _____

Gas _____

Oil _____

Total Depth _____

PRODUCTION

1st 24 hrs. Nat. _____

1st 24 hrs. after shot _____

Gas _____ Cu. Ft.

Dry Hole 2665

Abandoned _____

Date

2/12 1920

Pyle

Scout