


Map No. 1 Sec. 20 Twp. 23 R. 9

Well No. 5 Harris Farm

Phillips Per Company

N

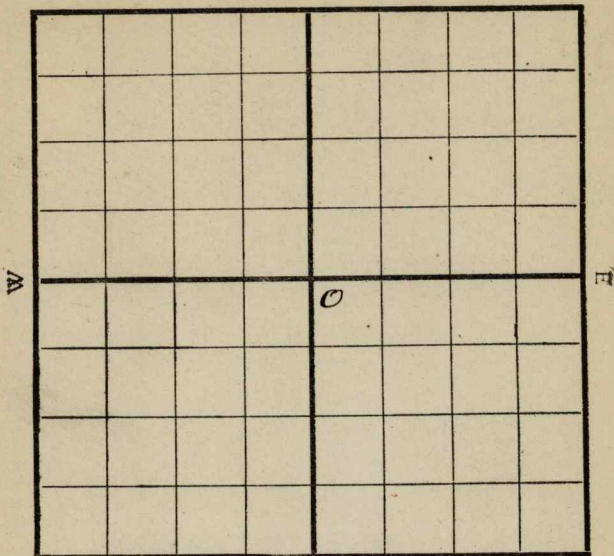

S

Location -----

Drilling Remarks:

Rig Up -----

Drilling Remarks:

RECORD

Cased ----- in.-----ft.

Sand -----

Gas -----

Oil -----

Total Depth_____

PRODUCTION

1st 24 hrs. Nat.-----

1st 24 hrs. after shot-----

Gas ----- cu. ft

Dry Hole -----

Abandoned -----

Sec. 20, Twp. 23, R. 9, Map No. K15

No. 1 Farm Morris
Phillips Pet. Company


200 from N. NORTH 200 from W.

[illegible]

SOUTH

Location _____

Rig up_____

Drilling and Remarks:

20 lg 300

RECORD

Cased _____ in., ft.

Sand _____

Gas _____

Oil _____

Total Depth

PRODUCTION

1st 24 hrs. Nat

1st 24 hrs. after shot

Gas _____ Cu. ft.

Dry Hole

Abandoned

Date _____

11.5 1922

M. S. Scout

Map No. K 15 Sec. 20 Twp. 23 R. 9Well No. 1 MorrisPhillips Pet. Company

Contractor

Was reported as
20-23-13.

SECTION PLAT

200' Ft. from N. Line

Ft. from S. Line

200' Ft. from E. Line

Ft. from W. Line

COMPLETED

Location

Rig up

Drilling and Remarks:

shot. 30 gk
pumping.
175 fth.

RECORD

Cased _____ in., _____ ft.

Sand _____

Gas _____

Oil 2552-2615Total Depth 2615

PRODUCTION

1st 24 hrs. Nat. _____

1st 24 hrs. after shot _____

Gas _____ Cu. Ft.

Dry Hole _____

Abandoned _____

Date

MAR 26 1922191 21

M. A. BENEAR

Scout