


Section 36 Township 27 Range 2-E

Well No. 2 Fee

Company National Refining

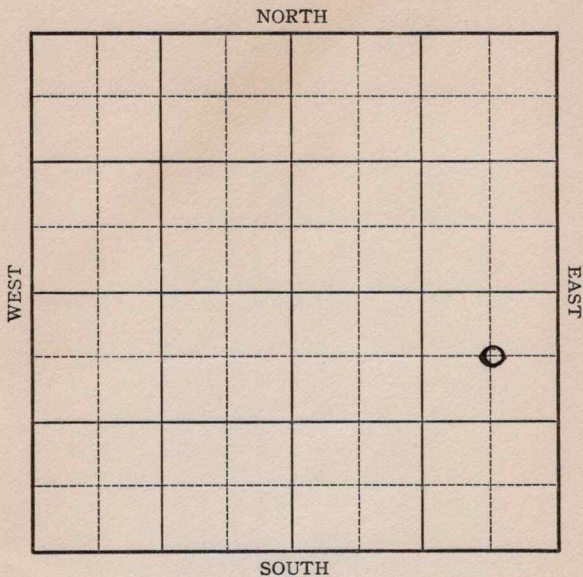

Sedgwick

KANSASMap No. 12 Sec. 36 Twp. 27 R. 2EWell No. 2 FeeNational Refining

Company

Contractor

FIRST REPORT

C NE SE

660 Ft. from N. Line Ft. from S. Line660 Ft. from E. Line Ft. from W. Line**SECTION PLAT**

			0

Location Rig up

Drilling and Remarks:

Ponds**RECORD**Cased in., ft.Sand Gas Oil Total Depth **PRODUCTION**1st 24 hrs. Nat. 1st 24 hrs. after shot Gas Cu. Ft.Dry Hole Abandoned

Date

H. D. HatfieldJAN 19 1938 19

Scout

Sedgwick

KANSAS

Map No. 12 Sec. 36 Twp. 27 R. 2EWell No. 2 Fee

National Refining

Company

Contractor

ABANDONED

C NE SE

660 Ft. from N. Line Ft. from S. Line660 Ft. from E. Line Ft. from W. Line

SECTION PLAT

			0

Location Rig up

Drilling and Remarks:

RECORD

Cased 6 in., 1905 ft.Sand Stalmer 1997Gas HFW 2024Oil Lans 2039Total Depth 2082

PRODUCTION

1st 24 hrs. Nat. 1st 24 hrs. after shot Gas Cu. Ft.Dry Hole Abandoned

Date

FEB 23 1938

19

H. D. Hatfield Scout