KANSAS


FORM 51 5M 2-38 TPCO.

Sedgwick

Section 36 Township 27 Range 2-E

Well No. 1 Wilson

Company National Ref.

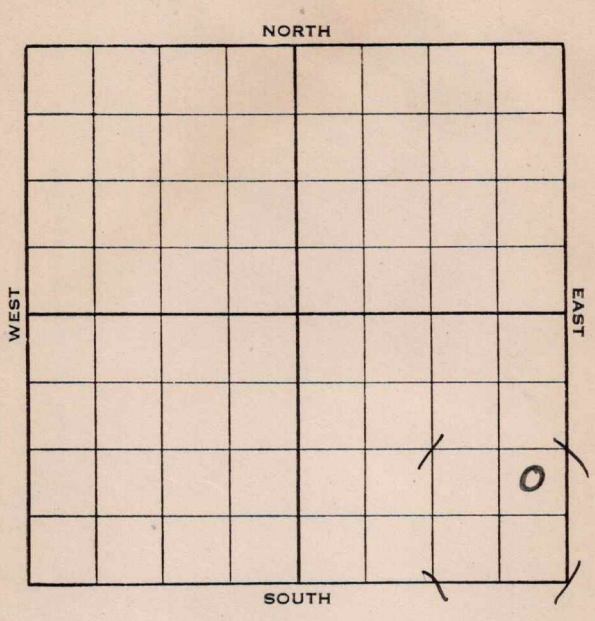

FORM 252-A 5M 1-38 KANSAS Sedgwick

Sec. 36 Twp. 27 R. 2-E

Well No. #1 Wilson Farm


National Refg. Company

990 Ft. from N. Line

Ft. from S. Line

330 Ft. from E. Line

Ft. from W. Line

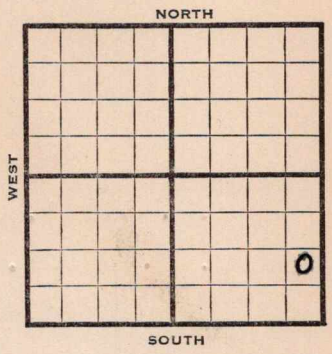

Elev. 1304

1938	REPORT
3/23	B.C.R.
4/1	R. U.
4/8	20" @ 70'. Drlg. 215'.
4/15	15" @ 599'. Drlg. 1005'.
4/22	Drlg. 1850'.
4/29	12" @ 1259'.
	Stalnaker 2012'.
	Lans. 2037'. K. C. 2361'.
	10" @ 2042'. 8" @ 2475'.
	Drlg. 2605'.
5/6	Miss. 2824'. 6" @ 2816'.
	H.F.W. 2905-15'.
	T.D. 2926'. U. R.
5/12	6" @ 2925'. Wilcox 3104'.
	400' oil 3104-08'.
	T.D. 3110'. S.W. P.B. 3109'.
	2500' oil 48 hrs.

OVER

756491

1938

5/18 5" @ 3104' ?
Wilcox 3104'.
T.D. 3110'.
P. B. 3109'.
Potential 240 bbls.
No water.

COMPLETED

Form 26—1M Bks.—2-29 Sedgwick KANSAS

Map No. 12 Sec. 36 Twp. 27 R. 2E

Well No. 1 Wilson

National Ref. Company

Contractor

FIRST REPORT

NE SE SE


_____ Ft. from N. Line

990 Ft. from S. Line

330 Ft. from E. Line

_____ Ft. from W. Line

SECTION PLAT

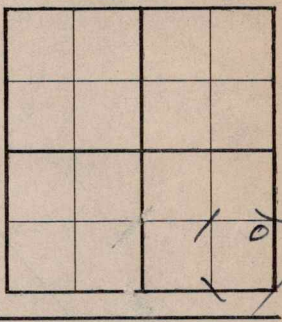

Location _____

Rig up _____

Drilling and Remarks:

BCR

RECORD

Cased _____ in., _____ ft.

Sand _____

Gas _____

Oil _____

Total Depth _____

PRODUCTION

1st 24 hrs. Nat. _____

1st 24 hrs. after shot _____

Gas _____ Cu. Ft.

Dry Hole _____

Abandoned _____

Date

MAR 23 1936 19 H. D. Hatfield Scout

Form 26—1M Bks.—2-29

Sedgwick KANSAS

Map No. 12 Sec. 36 Twp. 27 R. 2E

Well No. 1 Wilson

National Refining Company

Contractor

COMPLETED

NE SE SE


Ft. from N. Line

990 Ft. from S. Line

330 Ft. from E. Line

Ft. from W. Line

SECTION PLAT

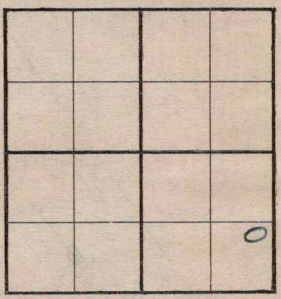

Location

Rig up

Drilling and Remarks:

P.B. 3109

Pot 240 No wtr

RECORD

Cased 5 in., 3104 ? ft.

Sand Wilcox 3104

Gas

Oil

Total Depth 3110

PRODUCTION

1st 24 hrs. Nat.

1st 24 hrs. after shot

Gas Cu. Ft.

Dry Hole

Abandoned

Date

MAY 18 1938 19

H. D. Hatfield Scout