FORM 51 10M 7-48 PETROL


KANSAS Greenwood

Section 20 Township 23 Range 9-E

Well No. #6 Morris

Company Magnolia

Miscellaneous

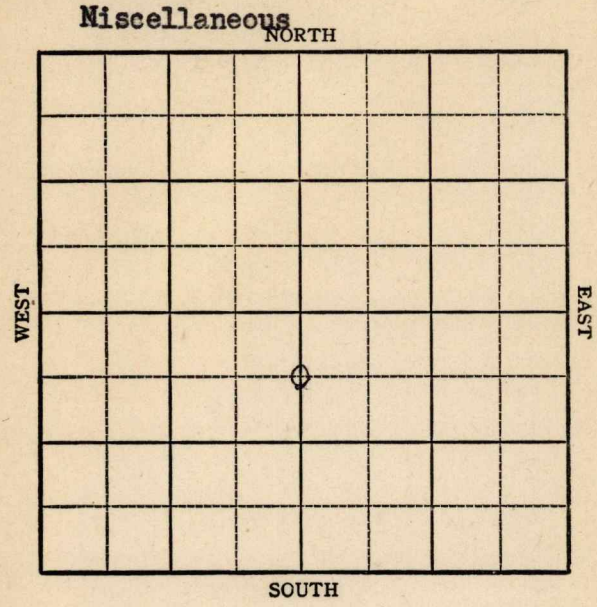

FORM 252-A
5M 10-48 PETROL

KANSAS

Sec. 20 Twp. 23 Greenwood R. 9E ✓

Well No. #6 Morris Farm

Magnolia Company

Miscellaneous


660' Ft. from N. Line

_____ Ft. from S. Line

2640' Ft. from E. Line

_____ Ft. from W. Line

C N½ S½ Sec.

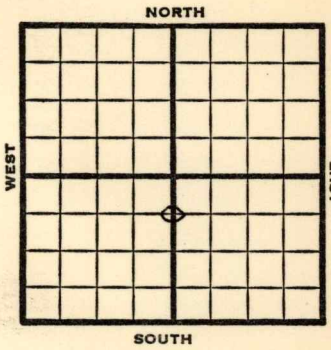

1948	REPORT
12/1	Location
12/6	8" @ 111'
12/14	"
12/22	Miss 2665'
12/29	SD TD 2665' Miss 2655' Aband.

ABANDONED

Form 26 200 Bks. 9-48 Petrol

Kansas

Miscellaneous

Map No. _____ Sec. 20 Twp. 23 R. 9E


Well No. 6 Morris

Magnolia Company

FIRST REPORT Contractor

C N½ S½ Sec.

SECTION PLAT

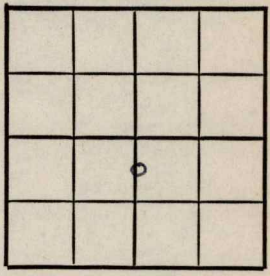

660 Ft. from N. Line

_____ Ft. from S. Line

2640 Ft. from E. Line

_____ Ft. from W. Line

Greenwood County

Location x

Rig up _____

Drilling and Remarks:

RECORD

Cased _____ in., _____ ft.

Sand _____

Gas _____

Oil _____

Total Depth _____

PRODUCTION

1st 24 hrs. Nat. _____

1st 24 hrs. after shot _____

Gas _____ Cu. Ft.

Dry Hole _____

Abandoned _____

Date

DEC 1 1948

19 _____

S. J. LEWIS Scout

Form 26 200 Bks. 9-48 Petrol

Kansas

Miscellaneous

Map No. 15 Sec. 20 Twp. 23 R. 9E

Well No. 6 Morris

Magnolia Company

ABANDONED

Contractor

C N½ S½ Sec.

660 Ft. from N. Line


Ft. from S. Line

2640 Ft. from E. Line

Ft. from W. Line

Greenwood County

SECTION PLAT

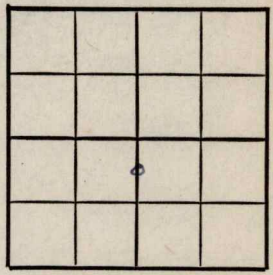

Location

Rig up

Drilling and Remarks:

Mud 2655'

RECORD

Cased in., ft.

Sand

Gas

Oil

Total Depth 2665

PRODUCTION

1st 24 hrs. Nat.

1st 24 hrs. after shot

Gas Cu. Ft.

Dry Hole

Abandoned

Date

DEC 29 1948 19

S. J. LEWIS Scout