

KANSAS


Form 51—5M—7-40—Palace

Sedgwick

Section 35 Township 27 Range 2-E

Well No. #1 Aylward

Company Aylward Production

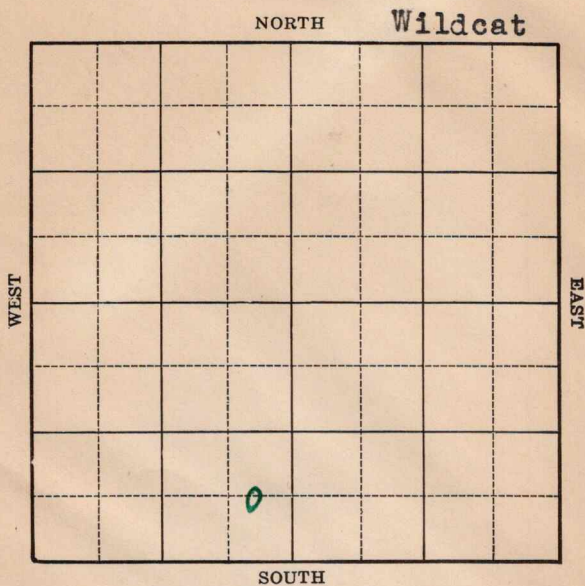

KANSAS


Sedgwick

Sec. 35 Twp. 27 R. 2-EWell No. #1 Aylward FarmAylward Production Company

(Wildcat)

 Ft. from N. Line660 Ft. from S. Line330 Ft. from E. Line Ft. from W. Line

Elev. 1333

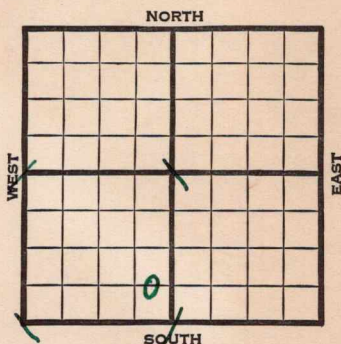

1941	REPORT
2/26	Cable.
3/6	"
3/13	"
3/20	"
3/27	"
4/3	15" - 94'
	Drlg. 550'
4/10	12" - 840' Drlg. 1140'
4/18	12" - 1108' Drlg. 1795'
4/24	10" - 1970' K.C. 2445'
	Drlg. 2485'
5/1	8" - 2545' T.D. 2768' U.R. 8"
5/8	8" - 2620' Drlg. 2915'
5/14	Arb. 3307'
	T.D. 3324'
	Water.
	ABANDONED


Map No. 12 Sec. 35 Twp. 27 R. 2EWell No. 1 AylwardAylward Production CompanyFIRST REPORT Contractor

C E L S E S W

 Ft. from N. Line660 Ft. from S. Line330 Ft. from E. Line Ft. from W. Line

WILDCAT

SECTION PLAT

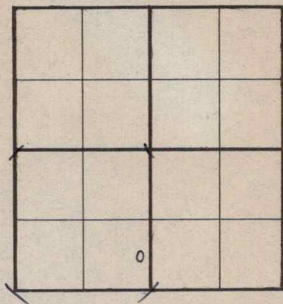Location Rig up

Drilling and Remarks:

Cable

RECORD

Cased in., ft.Sand Gas Oil Total Depth

PRODUCTION

1st 24 hrs. Nat. 1st 24 hrs. after shot Gas Cu. Ft.Dry Hole Abandoned

Date

FEB 26 1941 19S. J. LEWIS Scout

Map No. 12 Sec. 35 Twp. 27 R. 2EWell No. 1 AylwardAylward Production CompanyABANDONED Contractor


C E L S E S W

____ Ft. from N. Line

660 Ft. from S. Line330 Ft. from E. Line

____ Ft. from W. Line

SECTION PLAT

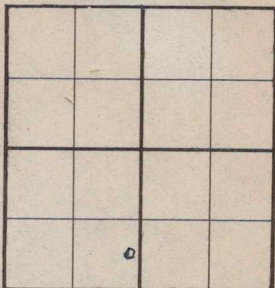

WILDCAT

Location _____

Rig up _____

Drilling and Remarks:

*Cr & 3307**Water*

RECORD

Cased _____ in., _____ ft.

Sand _____

Gas _____

Oil _____

Total Depth 3324

PRODUCTION

1st 24 hrs. Nat. _____

1st 24 hrs. after shot _____

Gas _____ Cu. Ft.

Dry Hole _____

Abandoned _____

Date

MAY 14 1941 19S. J. LEWIS Scout